

LAND CORNER RECORDATION CERTIFICATE
 Filing Requirement of Act 74, Mich. P.A. 1970

For corners in

<u>MACOMB</u> (County)	Located in: City of Sterling Heights	Corner Code # E-12
1. Public Land Survey	T <u>2N</u> R <u>12E</u>	<u>E-12</u>
	T _____ R _____	_____
	T _____ R _____	_____
	T _____ R _____	_____
2. Property Controlling in Section	S _____ T _____ R _____	_____
	S _____ T _____ R _____	_____
3. Miscellaneous Property in Sec.	S _____ T _____ R _____	_____
	S _____ T _____ R _____	_____

SURVEY &
 RESTORATION


MAR 15 1999

SECTION

Register of Deeds Stamp & File Number

4. Lot No. _____, Recorded Plat _____
 5. Private Claims _____

I, Bruce Antcliff, in a field survey on September 2 19 98, do hereby certify that under requirements of P.A. 74 Michigan P.A. of 1970, the corner points mentioned in lines 1 and 2 above were in conformance with regulations and rules therefore as required in the current manual of survey instructions of the United States Department of the Interior, Bureau of Land Management or by a decree of a Court of Law and/or that the corner points mentioned in lines 3, 4 and 5 above were in conformance with the rules of the Michigan Board of Land Surveyors or by a Decree of a Court of Law; established, re-established, monumented, re-monumented, recovered, found as expressed below:

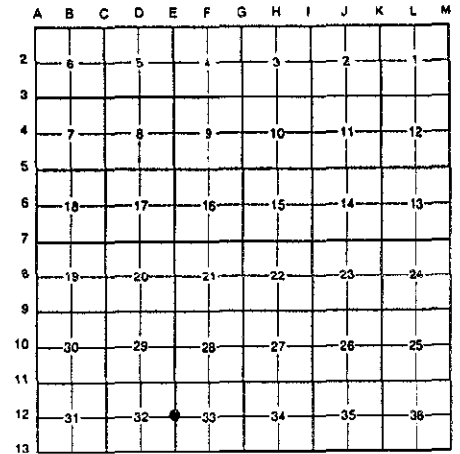

NOTE: Not more than 4 corners, all in the same town and range, may be recorded on this certificate.

A. Description of original monument and accessories and/or subsequent restoration:


E-12	1817	G.L.O. Notes	Wampler	N/A	Post
	1939	Sup. Plat of Mound Gardens L. 19 P. 49	Nampa	#1636	N/A
	1939	Sup. Plat of Riverside Farms L. 19 P. 35	Lehner	N/A	N/A
	1986	L.C.R.C. L. 4069 P. 34	Ward	#22445	1" Iron Pipe
	1986	L.C.R.C. L. 5290 P. 291	Avey	#30076	1" Pipe in C/L Median
	1987	L.C.R.C. L. 4369 P. 433	Soderberg	#17635	1" Pipe in Median
	1993	MCRC Wits.	Campbell	N/A	1/2" Pipe
	1994	L.C.R.C. L. 6536 P. 638	Platz	#38121	1" Iron Pipe
	1996	MCRC Align. Sht.	N/A	N/A	1/2" Pipe

B. Description of corner evidence found and/or method applied in restoring or reestablishing corner:

E-12 I found a 1/2" rebar in a monument box 3' + West of the C/L of a median between the northbound and southbound lanes of Mound Road (conc.), on line of a tree row running West, which checks Supervisor's Plat of Riverside Farms, Mound Road Alignment Sheet, and with the witnesses listed below.

L.C.R.C. L. 4369 P. 433	MCRC Alignment Sheet
North 53.06' C/L W Face of U.P. (m. 53.30')	East 103.35' P.K. DE Pole (m. 103.40')
South 99.04' P.K. & MSDH Tag W Face U.P. (m. 99.01')	South 99.15' P.K. DE Pole (m. 99.01')
ESE 103.32' P.K. S Face U.P. (m. 103.40')	

Measure South 2635.90' to E-13 (G.L.O. = 2640.0') (L. 4369 P. 433 = 2636.06') (Alignment Sheet = 2636.11')
 Measure North 2626.20' to E-11 (G.L.O. = 2640.0') (L. 4369 P. 433 = 2626.23')

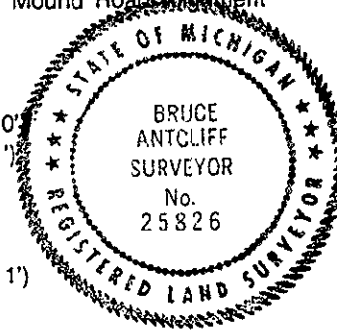

C. Description of monument for corner and accessories established to perpetuate locating the position of the corner:

E-12 I replaced the found 1/2" rebar with a 3/4" x 24" iron rod w/2" diameter aluminum cap stamped "Macomb County Monument MI Act 345 #25826" in an existing monument box.

N 01° W 53.30'	Set P.K. Nail with Remon tag in W Side Utility Pole
S 78° E 103.40'	Found P.K. Nail with Washer #19837 in NW Side Utility Pole
S 52° E 129.95'	Found P.K. Nail with Washer #12578 in N Side Utility Pole
South 99.01'	Set P.K. Nail with Remon tag in W Side Utility Pole

ACCEPTED BY THE MACOMB COUNTY SURVEY PER GROUP AS THE OFFICIAL CORNER UNDER MICHIGAN PUBLIC ACT 345 OF 1990 AT A MEETING HELD ON 10/27/98
William E. Soderberg
 WILLIAM E. SODERBERG, P.S., CHAIRMAN

The selected location is accepted by me and is generally accepted by professional surveyors as the best available evidence of the position of the original corner.

Signed by Bruce Antcliff Date 11-25-98
 EARTH TECH

Surveyor's Michigan License No. 25826

857