

SURVEY & REMONUMENTATION

C152249

APR 28 1995

LAND CORNER RECORDATION CERTIFICATE
Filing Requirement of Act 74, Mich. P.A. 1970

94 DEC 14 AM 10: 53

corners in **COMMISSION**
MACOMB
(County)

Located In: Sterling Township Corner Code F-5

Public Land Survey T 2N R 12E _____
T _____ R _____
T _____ R _____
T _____ R _____

Property Controlling S _____ T _____ R _____
in Section S _____ T _____ R _____
Miscellaneous S _____ T _____ R _____
Property in Sec. S _____ T _____ R _____

CALL REG. DEEDS MACOMB COUNTY MI

LIBER **6527** PAGE **826**

Register of Deeds Stamp & File Number

Lot No. _____, Recorded Plat _____
Private Claims _____

	A	B	C	D	E	F	G	H	I	J	K	L	M
2	6	5	4	3	2	1							
3													
4	7	8	9	10	11	12							
5													
6	18	17	16	15	14	13							
7													
8	19	20	21	22	23	24							
9													
10	30	29	28	27	26	25							
11													
12	31	32	33	34	35	36							
13													

Randy Kolehouse in a field survey on June 28, 19 94,
I hereby certify that under requirements of P.A. 74, Michigan P.A. of 1970, the corner points mentioned in lines 1 and 2 above were in conformance with regulations and rules therefore as required in the current manual of survey instructions of the United States Department of the Interior, Bureau of Land Management or by a decree of a Court of Law and/or that the corner points mentioned in lines 3, 4 and 5 above were in conformance with the rules of the Michigan Board of Land Surveyors or by a Decree of a Court of Law, established, re-established, monumented, re-monumented, recovered, found as pressed below:

NOTE: Not more than 4 corners, all in the same town and range, may be recorded on this certificate.

Description of original monument and accessories and/or subsequent restoration:

-5	1817	G.L.O.	Notes	Wampler	NA	Post
	1978	L.C.R.C.	L. 2936 P. 221	Hooth	#7966	1/2" Pipe in Mon. Box

Description of corner evidence found and/or method applied in restoring or reestablishing corner:

5 Found 3/4" rebar in monument box in center line of 18 Mile Road on east side of railroad tracks running north and south.

L.C.R.C. L. 2936 P. 221
PK and Tag W Face Telegraph Pole N 55.66'
PK and Tag E Face Power Pole S 40° W 72.97'
Center of Top of Fire Hydrant N 55° W 79.08'


Measure E 2696.2 to G-5 (G.L.O. 2672.34)
Measure W 2643.73 to E-5 (MDOT 2643.45) (G.L.O. 2672.34)

ACCEPTED BY THE MACOMB COUNTY SURVEY PEER GROUP AS THE OFFICIAL CORNER UNDER MICHIGAN PUBLIC ACT 345 OF 1990 AT A MEETING HELD ON 10-4-94
William E. Soderberg
WILLIAM E. SODERBERG, P.S., CHAIRMAN

Description of monument for corner and accessories established to perpetuate locating the position of the corner:

5 I replaced the found 3/4" Rebar with a 3/4" x 24" Iron Rod w/2" diameter aluminum cap stamped "Macomb County Monument MI Act 345 #25854" in an existing Monument Box.

PK with "MDSH" Tag W Face P. Pole N 5° E 55.85'
PK S Face P. Pole N 67° E 66.23'
PK with "MDSH" Tag S Face P. Pole S 48° E 86.10'
PK with "MDSH" Tag E Face P. Pole S 48° W 72.85'
Center Line Top Nut Fire Hydrant N 53° W 79.06'

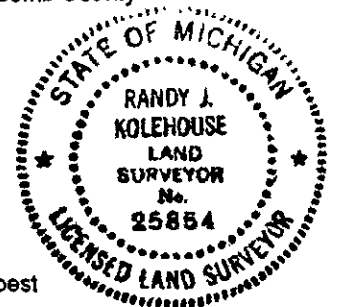

The selected location is accepted by me and is generally accepted by professional surveyors as the best available evidence of the position of the original corner.

Recorded by Randy J. Kolehouse Date 10/19/94
Surveyor's Michigan License No. 25854