

LAND CORNER RECORDATION CERTIFICATE  
 Filing Requirement of Act 74, Mich. P.A. 1970

For corners in

<u>MACOMB</u> (County)	Located in: City of Sterling Heights	Corner Code # F-11
1. Public Land Survey	T <u>2N</u> R <u>12E</u>	<u>F-11</u>
	T _____ R _____	_____
	T _____ R _____	_____
	T _____ R _____	_____
2. Property Controlling in Section	S _____ T _____ R _____	_____
	S _____ T _____ R _____	_____
3. Miscellaneous Property in Sec.	S _____ T _____ R _____	_____
	S _____ T _____ R _____	_____
4. Lot No. _____, Recorded Plat _____		
5. Private Claims _____		

REGISTER OF DEEDS  
 REGISTERED

MAR 15 1999

SECTION

Register of Deeds Stamp & File Number

A	B	C	D	E	F	G	H	I	J	K	L	M
2	6	5	4	3	2	1						
3												
4	7	8	9	10	11	12						
5												
6	16	17	18	15	14	13						
7												
8	19	20	21	22	23	24						
9												
10	30	29	28	27	26	25						
11												
12	31	32	33	34	35	36						
13												

I, Bruce Antcliff, in a field survey on September 2 19 98, do hereby certify that under requirements of P.A. 74 Michigan P.A. of 1970, the corner points mentioned in lines 1 and 2 above were in conformance with regulations and rules therefore as required in the current manual of survey instructions of the United States Department of the Interior, Bureau of Land Management or by a decree of a Court of Law and/or that the corner points mentioned in lines 3, 4 and 5 above were in conformance with the rules of the Michigan Board of Land Surveyors or by a Decree of a Court of Law; established, re-established, monumented, re-monumented, recovered, found as expressed below:

NOTE: Not more than 4 corners, all in the same town and range, may be recorded on this certificate.

A. Description of original monument and accessories and/or subsequent restoration:

F-11 See Back


B. Description of corner evidence found and/or method applied in restoring or reestablishing corner:

F-11 I found a 1" iron in a monument box on the C/L of 15 Mile Road running East and West 25' m/l East of the C/L of main track of railroad running North and South which checks L.C.R.C. L. 2940 P. 347, Cert. Survey L. 4790 P. 794 (1989) and MCRC Witness File No. 138 (1928)(1970). Also set a point from witnesses using L.C.R.C. 6536 P. 636 (1994). This point was set using L.C.R.C. L. 2936 P. 223 (1978) and falls in the approximate C/L of the main railroad track running North and South (25.19' West of iron in monument box). According to the Macomb County Tax Maps and the Subdivision of Bart Industrial Park, the C.L. of the railroad right-of-way (50' wide) is the North-South 1/4 line of Sections 28 and 33, which would agree with the location of corners F-9 and F-13. It appears that iron in monument box was set on the East right-of-way line of said railroad.

Measure West 2572.12' to E-11 (G.L.O. = 2621.5') (Bart Industrial Park = 2572.3')  
 Measure East 2672.67' to G-11 (G.L.O. = 2621.5') (L.C.R.C. L. 6536 P. 636 = 2672.74')

C. Description of monument for corner and accessories established to perpetuate locating the position of the corner:

F-11 I replaced the found 1" iron with a 3/4" x 24" iron rod w/2" diameter aluminum cap stamped "Macomb County Monument Mi Act 345 #25826" in an existing monument box as a reference monument 25.19' East of F-11.

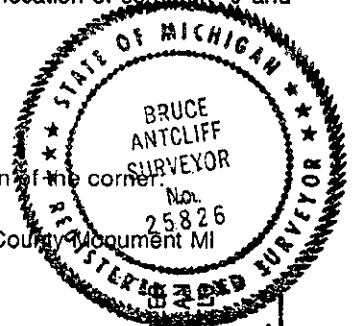

Witnesses to Ref. Mon.:	S 40° W 79.51'	Found P.K. Nail with Tag #19837 E Face of Utility Pole
	S 20° E 63.95'	Found P.K. Nail with Tag #19837 W Face Utility Pole
	N 10° E 39.55'	Found P.K. Nail & MDSH Tag W Face Utility Pole
	N 47° E 81.12'	Found P.K. Nail & MDSH Tag SE Face Utility Pole
	N 85° W 25.19'	True Location for F-11

Witnesses to F-11:	N 44° E 50.17'	Found P.K. Nail with M.D.S.H. Tag in W Side of Utility Pole
	N 59° E 100.53'	Found P.K. Nail with M.D.S.H. Tag in SE Side of Utility Pole
	S 37° E 76.66'	Found P.K. Nail with Tag #19837 in W Side of Utility Pole
	S 30° W 65.33'	Found P.K. Nail with Tag #19837 in SE Side of Utility Pole
	S 85° E 25.19'	Found 1" Pipe in Mon. Box (Wit. Cor.)
	East 3.16'	Found E Edge of E Rail of Main R.R. Tracks

The selected location is accepted by me and is generally accepted by professional surveyors as the best available evidence of the position of the original corner.

Antcliff  
 EARTH TECH

Date 11-25-98

File No. 25826

858

SURVEY &  
RECORDATION

1999

SECTION

A. Description of original monument and accessories and/or subsequent restoration:

F-11	Year	Description	Surveyor	Reference	Monument
	1817	G.L.O. Notes	Wampler	N/A	Post
	1928	MDOT Wit. File	N/A	N.A.	3/4" Gas Pipe
	1964	Sterling Twp. Wits.	G.C.	N/A	R.R. Spike - <i>SET Mon Box</i>
	1970	MDOT Wit. File	Pierson	#13039	1" Pipe in Mon. Box
	1978	L.C.R.C. L. 2940 P. 347	Patterson	#17631	Iron in Monument Box
	1978	L.C.R.C. L. 2936 P. 223	Hooth	#7966	3/4" Iron Pipe in Mon. Box - Wit. Mon.
	1979	Bart Ind. Pk. L. 75 P. 8	Menzel	#7313	N/A
	1987	MDOT Wits. Proj. #26271A	N/A	N/A	3/4" Pipe in Mon. Box - Ref. Mon.
	1989	Survey L. 4790 P. 794	Soderburg	#17635	Pipe in Mon Box
	1994	L.C.R.C. L. 6536 P. 636	Platz	#38121	Set 1/2" Iron Rod with Cap #38121

C0863642 LIBER:08565 PAGE:881 09:45A 01/19/1999  
CARMELLA SABAUGH-MACOMB COUNTY, MI REG/DEEDS