

SURVEY & REMONUMENTATION

APR 28 1995

C152251

COMMISSION

LAND CORNER RECORDATION CERTIFICATE

Filing Requirement of Act 74, Mich. P.A. 1970

94 DEC 14 AM 10:54

OFFICE OF THE CLERK OF COURTS
MACOMB COUNTY, MICHIGAN

LIBER 6527 PAGE 828


Register of Deeds Stamp & File Number

Corner in
MACOMB
(County)

Located In: Sterling Township Corner Code #

Public Land Survey	T <u>2N</u> R <u>12E</u>	<u>G-3</u>
	T _____ R _____	_____
	T _____ R _____	_____
	T _____ R _____	_____
Property Controlling in Section	S _____ T _____ R _____	_____
Miscellaneous	S _____ T _____ R _____	_____
Property in Sec.	S _____ T _____ R _____	_____

Lot No. _____, Recorded Plat _____
Private Claims _____

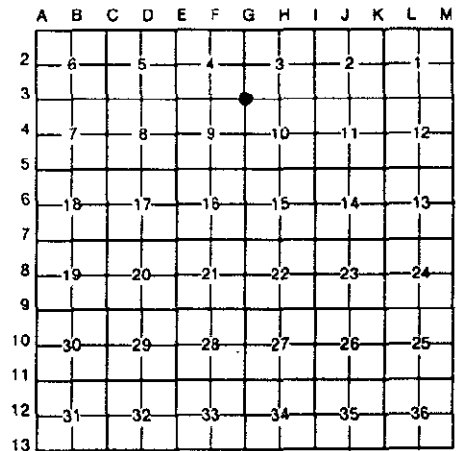

Randy Kolehouse in a field survey on June 28, 19 94,
whereby certify that under requirements of P.A. 74, Michigan P.A. of 1970, the corner points mentioned in lines 1 and 2 above were in conformance with regulations and rules therefore as required in the current manual of survey instructions of the United States Department of the Interior, Bureau of Land Management or by a decree of a Court of Law and/or that the corner points mentioned in lines 3, 4 and 5 above were in conformance with the rules of the Michigan Board of Land Surveyors or by a Decree of a Court of Law; established, re-established, monumented, re-monumented, recovered, found as expressed below:

NOTE: Not more than 4 corners, all in the same town and range, may be recorded on this certificate.

Description of original monument and accessories and/or subsequent restoration:

3	1817	G.L.O.	Notes	Wampler	NA	Post
	1972	Survey	L. 2307 P. 741	Ciemochowski	#13577	
	1975	Survey	L. 2564 P. 447	Avey	#15396	
	1975	L.C.R.C.	L. 2565 P. 635 & 636	Pawlaczyk	#17632	Iron in Mon. Box
	1975	L.C.R.C.	L. 2569 P. 381 & 382	Pawlaczyk	#17632	Iron in Mon. Box
	1988	L.C.R.C.	L. 4507 P. 847	Spencer	#13044	1/2" Iron in Mon. Box

Description of corner evidence found and/or method applied in restoring or reestablishing corner:

3 Found 1/2" rebar in monument box on center line of Van Dyke 400' ± N of center line of 19 Mile Road.

L.C.R.C. L. 4507 P. 847
Nail and MDOT Tag in 9" Maple S 40° E 73.91'
Nail and MDOT Tag in Lt. Pole N 25° W 106.40'
Center Line Top Hyd. S 30° W 122.58'

ACCEPTED BY THE MACOMB COUNTY SURVEY PEER GROUP AS THE OFFICIAL CORNER UNDER MICHIGAN PUBLIC ACT 345 OF 1990 AT A MEETING HELD ON 8-16-94
William E. Soderberg
WILLIAM E. SODERBERG, P.S., CHAIRMAN


Note: All witnesses from earlier L.C.R.C.'s have been destroyed.

Measure W. 2664.95 to F-3 (Survey L. 2564 P. 447 = 2664.83) (G.L.O. 2673)
Measure S. 2701.14 to G-4 (Survey L. 2564 P. 447 = 2700.99) (G.L.O. 2640)
Measure E. 2634.22 to H-3 Measure 2598.78 to G-2 (G.L.O. 2640)

Description of monument for corner and accessories established to perpetuate locating the position of the corner:

3 I replaced the found 1/2" Rebar with a 3/4" x 24" Iron Rod w/2" diameter aluminum cap stamped "Macomb County Monument MI Act 345 #25854" in an existing Monument Box.

Nail with Tag SW Face of Lt. Pole N 24° E 106.38'
Center Line Top Nut on Hyd. S 27° W 122.59'
Nail with MDOT Tag SW Face 10" Maple S 42° W 73.91'
PK with Macomb Co. Remon. Tag S'y Side of P. Pole N 76° E 58.41'

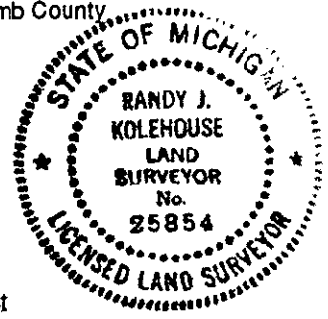

The selected location is accepted by me and is generally accepted by professional surveyors as the best available evidence of the position of the original corner.

Witnessed by Randy J. Kolehouse Date 10/14/94
Surveyor's Michigan License No. 25854