

# SURVEY & REMONUMENTATION

APR 28 1995

COMMISSION

## LAND CORNER RECORDATION CERTIFICATE Filing Requirement of Act 74, Mich. P.A. 1970

0152255

94 DEC 14 AM 10: 54

MACOMB COUNTY REGISTER OF DEEDS  
MACOMB COUNTY, MI

or corners in  
MACOMB  
(County)


Located In: Sterling Township Corner Code ##

Public Land Survey	T <u>2N</u> R <u>12E</u>	<u>G-7</u>
	T _____ R _____	_____
	T _____ R _____	_____
	T _____ R _____	_____
Property Controlling in Section	S _____ T _____ R _____	_____
Miscellaneous	S _____ T _____ R _____	_____
Property in Sec.	S _____ T _____ R _____	_____

LIBER **6527** PAGE **832**

Register of Deeds Stamp & File Number

Lot No. \_\_\_\_\_, Recorded Plat \_\_\_\_\_  
Private Claims \_\_\_\_\_

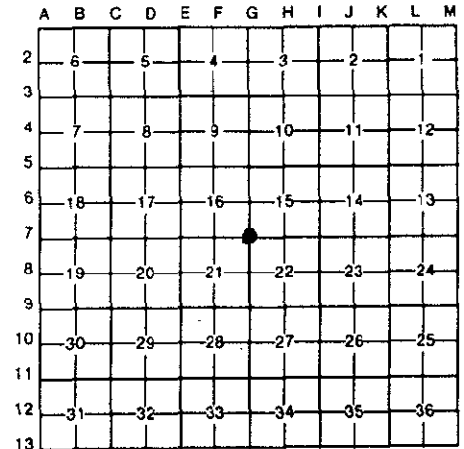

Randy Kolehouse, in a field survey on June 28, 19 94,  
I hereby certify that under requirements of P.A. 74, Michigan P.A. of 1970, the corner points mentioned in lines 1 and 2 above were in conformance with regulations and rules therefore as required in the current manual of survey instructions of the United States Department of the Interior, Bureau of Land Management or by a decree of a Court of Law and/or that the corner points mentioned in lines 3, 4 and 5 above were in conformance with the rules of the Michigan Board of Land Surveyors or by a Decree of a Court of Law; established, re-established, monumented, re-monumented, recovered, found as expressed below:

**NOTE: Not more than 4 corners, all in the same town and range, may be recorded on this certificate.**

Description of original monument and accessories and/or subsequent restoration:

3-7	1817	G.L.O.	Notes	Wampler	NA	Post
	1978	L.C.R.C.	L. 2936 P. 226	Hooth	#7966	Conc. Mon. in Mon. Box
	1980	Survey	L. 3281 P. 839	Merdzinski	#10697	Conc. Mon. in Mon. Box
	1980	Survey	L. 3281 P. 783	Merdzinski	#10697	Conc. Mon. in Mon. Box
	?	MCRC	File 85	NA	NA	1/2" Solid Rod in Mon. Box

Description of corner evidence found and/or method applied in restoring or reestablishing corner:

3-7 Found concrete monument in monument box at center line intersection of Van Dyke & 17 Mile Road

MCRC Wit.  
4" Conc. Mon. (BM) NW 127.38'  
L.C.R.C. L. 2936 P. 226  
SW Cor. of W Leg Sign S 45° E 101.94'

Note: All other witnesses have been destroyed.

Measure N. 2608.56 to G-6 (MDOT 2608.08) (G.L.O. 2640)  
Measure E. 2587.70 to H-7 (G.L.O. 2609.6)  
Measure W. 2685.93 to F-7 (Williams & Works 2686.08) (G.L.O. 2647.3)

ACCEPTED BY THE MACOMB COUNTY SURVEY REEF GROUP AS THE OFFICIAL CORNER UNDER MICHIGAN PUBLIC ACT 345 OF 1990 AT A MEETING HELD ON 8-16-94

William E. Soderberg  
WILLIAM E. SODERBERG, P.S., CHAIRMAN

Description of monument for corner and accessories established to perpetuate locating the position of the corner:

3-7 I placed a 2" diameter aluminum cap stamped "Macomb County Monument MI Act 345 #25854," on the existing Concrete Monument, in an existing Monument Box.

PK SE'y Face Util. Pole N 61° W 123.19'  
PK SE'y Face Util. Pole S 58° W 134.57'  
SW Cor. "I" Beam West Leg. of Sign S 43° E 101.94'  
PK SE Face Util. Pole N 56° E 88.96'  
PK E Face Util. Pole N 18° E 58.17'



The selected location is accepted by me and is generally accepted by professional surveyors as the best available evidence of the position of the original corner.

Witnessed by Randy J. Kolehouse Date 10/14/94  
Surveyor's Michigan License No. 25854