

C0863643 LIBER:08565 PAGE:882 09:45A 01/19/1999
 CARMELLA SABAUGH-MACOMB COUNTY, MI REG/DEEDS
 LAND CORNER RECORDATION CERTIFICATE
 Filing Requirement of Act 74, Mich. P.A. 1970

For corners in

MACOMB (County)	Located in:	City of Sterling Heights	Corner Code #
1. Public Land Survey	T <u>2N</u>	R <u>12E</u>	<u>G-8</u>
	T _____	R _____	_____
	T _____	R _____	_____
	T _____	R _____	_____
2. Property Controlling in Section	S _____	T _____	R _____
	S _____	T _____	R _____
3. Miscellaneous Property in Sec.	S _____	T _____	R _____
	S _____	T _____	R _____

SECURITY &
 REPRODUCTION


MAR 15 1999

SECTION

Register of Deeds Stamp & File Number

4. Lot No. _____, Recorded Plat _____
 5. Private Claims _____


I, Bruce Antcliff, in a field survey on September 3 19 98, do hereby certify that under requirements of P.A. 74 Michigan P.A. of 1970, the corner points mentioned in lines 1 and 2 above were in conformance with regulations and rules therefore as required in the current manual of survey instructions of the United States Department of the Interior, Bureau of Land Management or by a decree of a Court of Law and/or that the corner points mentioned in lines 3, 4 and 5 above were in conformance with the rules of the Michigan Board of Land Surveyors or by a Decree of a Court of Law; established, re-established, monumented, re-monumented, recovered, found as expressed below:

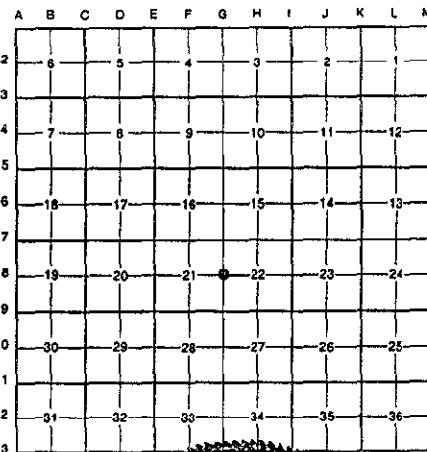

NOTE: Not more than 4 corners, all in the same town and range, may be recorded on this certificate.

A. Description of original monument and accessories and/or subsequent restoration:

G-8	1817	G.L.O. Notes	Wampler	N/A	Post
		N/A	M.C.R.C.	N/A	1" Iron
	1973	Cert. Survey L. 2370 P. 605	Kattouah	#14095	Iron Pin in Mon. Box
	1973	Cert. Survey L. 2391 P. 131	Kattouah	#14095	Iron Pin in Mon. Box
	1973	Cert. Survey L. 2396 P. 862	Kattouah	#14095	Iron Pin in Mon. Box
	1978	L.C.R.C. L. 2936 P. 227	Hooth	#7966	Conc. Mon. in Mon. Box
	1987	MDOT Wit. Proj. #26271A	N/A	N/A	Mon. in Mon. Box

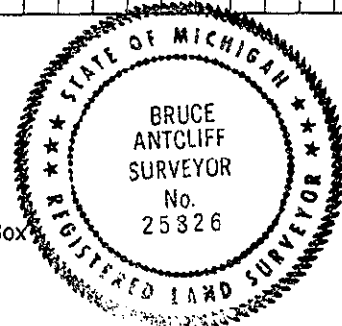

B. Description of corner evidence found and/or method applied in restoring or reestablishing corner:

G-8 I found a concrete monument with cap #30092 in the median of Van Dyke Road 5.30' West of the West back curb of northbound Van Dyke Road (conc.) and 3' South of the C/L of 16-1/2 Mile Road (asph.) running East (extended West) which checks with witnesses listed below.

L.C.R.C. L. 2936 P. 227 MDOT Witness Sheet
 N 50° E - 113.73 - S.W. Cor. Bldg. #38100 (m. 113.04) N 50° E - 113.73 - SW Cor. Bldg. #38100 (m. 113.04')

Measure North 2688.96' to G-7 (G.L.O. = 2640.0') (MDOT = 2688.46')
 Measure South 2618.85' to G-9 (G.L.O. = 2640.0') (MDOT = 2618.06')

C. Description of monument for corner and accessories established to perpetuate locating the position of the corner:

G-8 I placed a 2" diameter aluminum cap stamped "Macomb County Monument MI Act 345 #25826" on an existing concrete monument.

N 62° E 113.04' Found SW Cor. Bldg. #38100
 S 61° E 78.26' Found P.K. Nail with Tag "WES 17635" in SW Face Utility Pole
 S 52° W 34.24' Set "X" in NE Rim Storm Manhole
 N 45° W 37.54' Set "X" in SE Rim Storm Manhole

ACCEPTED BY THE MACOMB COUNTY SURVEY P
 GROUP AS THE OFFICIAL CORNER UNDER MICH
 PUBLIC ACT 345 OF 1990 AT A MEETING H
 ON 10/27/98
 William E. Soderberg
 WILLIAM E. SODERBERG, P.S., CHAIRMAN

The selected location is accepted by me and is generally accepted by professional surveyors as the best available evidence of the position of the original corner.

Signed by Bruce Antcliff Date 11-25-98
 EARTH TECH

Surveyor's Michigan License No. 25826

859