

**SURVEY & REMONUMENTATION**

APR 29 1996

COMMISSION

C0247600 LIBER:06753 PAGE:295 01:11P 09/07/1995  
 CARMELLA SABAUGH-MACOMB COUNTY, MI REG/DEEDS  
**LAND CORNER RECORDATION CERTIFICATE**  
 Filing Requirement of Act 74, Mich. P.A. 1970

For corners in

<u>MACOMB</u> (County)	Located In: <u>STERLING</u>	Corner Code # <u>G-13</u>
1. Public Land Survey	T <u>2N</u> R <u>12E</u>	<u>G-13</u>
	T _____ R _____	_____
	T _____ R _____	_____
	T _____ R _____	_____
2. Property Controlling in Section	S _____ T _____ R _____	_____
	S _____ T _____ R _____	_____
3. Miscellaneous Property in Sec.	S _____ T _____ R _____	_____
	S _____ T _____ R _____	_____

Register of Deeds Stamp & File Number

4. Lot No. \_\_\_\_\_, Recorded Plat \_\_\_\_\_  
 5. Private Claims \_\_\_\_\_

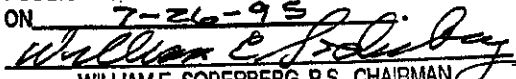
	A	B	C	D	E	F	G	H	I	J	K	L	M
2	6	6	4	3	2	1							
3													
4	7	8	9	10	11	12							
5													
6	18	17	16	15	14	13							
7													
8	18	20	21	22	23	24							
9													
10	30	28	28	27	26	25							
11													
12	31	32	33	34	35	36							
13													

I, STEVEN E. DUNN, in a field survey on MARCH 9, 1995, do hereby certify that under requirements of P.A. 74, Michigan P.A. of 1970, the corner points mentioned in lines 1 and 2 above were in conformance with regulations and rules therefore as required in the current manual of survey instructions of the United States Department of the Interior, Bureau of Land Management or by a decree of a Court of Law and /or that the corner points mentioned in lines 3, 4 and 5 above were in conformance with the rules of the Michigan Board of Land Surveyors or by a Decree of a Court of Law; established, re-established, monumented, re-monumented, recovered, found as expressed below:

**NOTE: Not more than 4 corners, all in the same town and range, may be recorded on this certificate.**

A. Description of original monument and accessories and/or subsequent restoration:

GLO POST - NO EVIDENCE OF ORIGINAL CORNER FOUND  
 GLO ORIGINAL SURVEY PERFORMED BY JOSEPH WAMPLER 1817

ACCEPTED BY THE MACOMB COUNTY SURVEY PEER GROUP AS THE OFFICIAL CORNER UNDER MICHIGAN PUBLIC ACT 345 OF 1990 AT A MEETING HELD ON 7-26-95  
  
 WILLIAM E. SODERBERG, P.S., CHAIRMAN

M.C.R.C. WITNESS CARD (UNRECORDED - NO NAME - NO DATE - NO MENTION OF CORNER)

<u>L.C.R.C.</u>	<u>NAME AND NUMBER</u>	<u>DESCRIPTION</u>	<u>DATE</u>
L. 4369, P. 438	WILLIAM E. SODERBERG #17635	FOUND 3/4" REBAR IN MONUMENT BOX	FEB. 16, 1988
L. 6536, P. 635	GEORGE M. PLATZ #38121	FOUND 3/4" REBAR IN MONUMENT BOX	DEC. 27, 1994

B. Description of corner evidence found and/or method applied in restoring or reestablishing corner:

G-13 SECTION CORNER COMMONLY BEING USED AS A COMMON CORNER COMMON TO G-1, T.1N., R. 12 E.

FOUND 3/4" IRON ROD IN MONUMENT BOX IN CONCRETE PAVEMENT.  
 VERIFIED LOCATION BY COMPARING FOUND WITNESSES TIES OF L.C.R.C.'S AND DISTANCE FROM G-13 TO H-13 AS LISTED BELOW.

L.C.R.C.  
 L. 4369, P. 438  
 N. 60°W. 83.81' FOUND PK IN SW FACE OF UTILITY POLE (83.86' M.)  
 WEST 2459.68' SET PK NAIL (F-13) (2459.72' M.)  
 L. 6536, P. 635  
 AZ. 44° 130.08' SET PK NAIL WITH TAG #38121 IN SE FACE OF UTILITY POLE (130.06' M.)  
 AZ. 123° 80.57' SET PK NAIL WITH TAG #38121 IN NE FACE OF UTILITY POLE (80.52' M.)  
 WEST 2459.72' FOUND PK NAIL IN ASPHALT (F-13) (2459.72' M.)

FIELD MEASUREMENTS AND RECORDED DISTANCES  
 G-13 TO H-13 2604.94' M. (2604.85' PLATS & TAX DESCRIPTION) 40 CH GLO (2640.00' R.)  
 G-13 TO G-1 EAST 50 LK. (GLO) 33.00'

C. Description of monument for corner and accessories established to perpetuate locating the position of the corner:

G-13, T. 2N., R. 12E. REPLACED 3/4" IRON ROD WITH A 3/4" x 24" IRON ROD WITH 2" DIAMETER ALUMINUM CAP  
 STAMPED "MACOMB COUNTY MONUMENT MI. ACT 345 #28408" IN AN EXISTING MONUMENT BOX.

WITNESSES

S. 62° E.	80.52'	SET PK NAIL AND M.C.R. WITNESS TAG IN NE FACE OF UTILITY POLE.
N. 39° E.	130.06'	FOUND PK NAIL & TAG #38121 IN SE FACE OF UTILITY POLE.
N. 61° E.	86.54'	SET PK NAIL AND M.C.R. WITNESS TAG IN SE FACE OF UTILITY POLE.
N. 56°W.	83.86'	SET PK NAIL AND M.C.R. WITNESS TAG IN NE FACE OF UTILITY POLE.
S. 60°W.	78.62'	SET PK NAIL AND M.C.R. WITNESS TAG IN NW FACE OF UTILITY POLE.

THE SELECTED LOCATION IS ACCEPTED BY ME AND IS GENERALLY ACCEPTED BY PROFESSIONAL SURVEYORS AS THE BEST AVAILABLE EVIDENCE OF THE POSITION OF THE ORIGINAL CORNER

Signed by Steven E. Dunn Date Aug. 1, 1995  
 Surveyor's Michigan License No. 28408

