

LAND CORNER RECORDATION CERTIFICATE
 Filing Requirement of Act 74, Mich. P.A. 1970

For corners in

MACOMB
 (County)

Located in: City of Sterling Heights Corner Code # _____

1. Public Land Survey T 2N R 12E H-11
 T _____ R _____
 T _____ R _____
 T _____ R _____

2. Property Controlling S _____ T _____ R _____
 in Section S _____ T _____ R _____

3. Miscellaneous S _____ T _____ R _____
 Property in Sec. S _____ T _____ R _____

4. Lot No. _____, Recorded Plat _____

5. Private Claims _____

BUREAU OF
 RECONSTRUCTION


SEP 19 1998

SECTION

Register of Deeds Stamp & File Number

I, Bruce Antcliff, in a field survey on September 3 19 98, do hereby certify that under requirements of P.A. 74 Michigan P.A. of 1970, the corner points mentioned in lines 1 and 2 above were in conformance with regulations and rules therefore as required in the current manual of survey instructions of the United States Department of the interior, Bureau of Land Management or by a decree of a Court of Law and/or that the corner points mentioned in lines 3, 4 and 5 above were in conformance with the rules of the Michigan Board of Land Surveyors or by a Decree of a Court of Law; established, re-established, monumented, re-monumented, recovered, found as expressed below:

NOTE: Not more than 4 corners, all in the same town and range, may be recorded on this certificate.

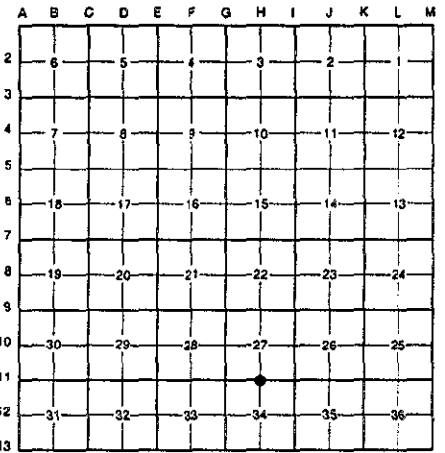

A. Description of original monument and accessories and/or subsequent restoration:

H-11	1817	G.L.O. Notes	Wampler	N/A	Post
	1945	Baumgartner's Estate Gardens L. 23, P. 8	Fall	N/A	N/A
	1966	Seville Gardens L. 56 P. 34	Lehner	5787	N/A
	1968	Greenview Sub. L. 59 P. 3	Mavis	#10400	N/A
	1978	L.C.R.C. L. 2936 P. 230	Hooth	#7066	3/4" Iron in Mon. Box
	1980	Survey L. 3293 P. 832	Soderburg	#17635	3/4" Iron in Mon. Box
	1987	MDOT Wil. Proj. #26271A	N/A	N/A	3/4" Iron in Mon. Box

B. Description of corner evidence found and/or method applied in restoring or reestablishing corner:

H-11 I found a 3/4" iron in a monument box on the C/L of 15 Mile Road (conc.) running East and West, on line of 5' high brick wall running North and checks with Greenview Sub., Seville Gardens Sub. and with witnesses listed below.

L.C.R.C. L. 2936 P. 230	MDOT Witness Sheet
Due North - 52.82' - Power Pole (m. 52.82')	North Power Pole 52.82' (m. 52.82')
S 60° W - 121.97' - Power Pole (m. 121.97')	S 60° W Power Pole 121.97' (m. 121.97')

Measure West 2537.24' to G-11 (G.L.O. = 2574.0') (Baumgartner's Sub. = 2547.60')
 Measure East 2667.04' to I-11 (G.L.O. = 2574.0') (Seville Gardens Sub. Calc. = 2666.55')

C. Description of monument for corner and accessories established to perpetuate locating the position of the corner:

H-11 I placed a 2" diameter aluminum cap stamped "Macomb County Monument MI Act 345 #25826" on the found 3/4" iron in an existing monument box.

N 07° E 52.82'	Found P.K. Nail (set P.K. Nail & Macomb Remon tag) in E Side of P. Pole
S 70° W 121.97'	Found P.K. Nail (set P.K. Nail & Macomb Remon tag) in N'y Side of P. Pole
N 76° E 156.61'	Set P.K. Nail & Macomb Remon Tag in S'y side of P. Pole
S 64° E 149.52'	Set P.K. Nail & Macomb Remon Tag in N'y Side P. Pole

ACCEPTED BY THE MACOMB COUNTY SURVEY PEER GROUP AS THE OFFICIAL CORNER UNDER MICHIGAN PUBLIC ACT 345 OF 1990 AT A MEETING HELD ON 10/27/98

William E. Soderberg
 WILLIAM E. SODERBERG, P.S., CHAIRMAN

The selected location is accepted by me and is generally accepted by professional surveyors as the best available evidence of the position of the original corner.

Signed by Bruce Antcliff Date 11-25-98

EARTH TECH

Surveyor's Michigan License No. 25826

[Handwritten signatures and initials]