

LAND CORNER RECORDATION CERTIFICATE
 Filing Requirement of Act 74, Mich. P.A. 1970

APR 07 1998

For corners in

MACOMB (County)	Located in: City of Sterling Heights	Corner Code #
1. Public Land Survey	T <u>2N</u> R <u>12E</u>	<u>I-1</u>
	T _____ R _____	_____
	T _____ R _____	_____
	T _____ R _____	_____
2. Property Controlling in Section	S _____ T _____ R _____	_____
	S _____ T _____ R _____	_____
3. Miscellaneous Property in Sec.	S _____ T _____ R _____	_____
	S _____ T _____ R _____	_____

SECTION

ACCEPTED BY THE MACOMB COUNTY SURVEY PEER GROUP AS THE OFFICIAL CORNER UNDER MICHIGAN PUBLIC ACT 345 OF 1990 AT A MEETING HELD ON 11/4/97
William E. Soderberg
 WILLIAM E. SODERBERG, P.S., CHAIRMAN

Register of Deeds Stamp & File Number

4. Lot No. _____, Recorded Plat _____
 5. Private Claims _____

	A	B	C	D	E	F	G	H	I	J	K	L	M
2	6		5		4		3		2				
3													
4	7		8		9		10		11				
5													
6	15		17		16		15		14				
7													
8	19		20		21		22		23				
9													
10	30		29		28		27		26				
11													
12	31		32		33		34		35				
13													

I, Randy Kolehouse, in a field survey on September 17 19 97, do hereby certify that under requirements of P.A. 74 Michigan P.A. of 1970, the corner points mentioned in lines 1 and 2 above were in conformance with regulations and rules therefore as required in the current manual of survey instructions of the United States Department of the Interior, Bureau of Land Management or by a decree of a Court of Law and/or that the corner points mentioned in lines 3, 4 and 5 above were in conformance with the rules of the Michigan Board of Land Surveyors or by a Decree of a Court of Law; established, re-established, monumented, re-monumented, recovered, found as expressed below:

NOTE: Not more than 4 corners, all in the same town and range, may be recorded on this certificate.

A. Description of original monument and accessories and/or subsequent restoration:

I-1 Records indicate this corner is common with I-13, T3N, R12E.

Date	Description	Surveyor	Notes	Post
1817	G.L.O. Notes	Wampler	N/A	Post
1925	Utica Gardens L. 9 P. 67	W. Lehner	#1123	N/A
1957-62	MDOT Road Plans	N/A	N/A	N/A
1988	L.C.R.C. L. 4507 P. 850	Spencer	#13044	3/4" Iron Bar in Mon. Box
N/A	M.C. Tax Maps	N/A	N/A	N/A

B. Description of corner evidence found and/or method applied in restoring or reestablishing corner:

I-1 The M-59 bridge over M-53 has been rebuilt and the monument box in the bridge deck and all witness from L.C.R.C. L. 2293 P. 268 have been removed. Found a monument box (full of concrete) in the northbound lane of M-53 as illustrated in MDOT Highway Plans for M-53 (This box was directly under the monument box in the M-59 bridge.) All witnesses from L.C.R.C. L. 4507 P. 850 are gone. Accepted monument box as the corner.

Measure South 3287.56' to I-2 (G.L.O. = 3417.5')


C. Description of monument for corner and accessories established to perpetuate locating the position of the corner:

I-1 C/L of an existing monument box.

- N 37° E 72.57' - Found "+" in Station 21+00 East Edge Northbound M-53 Pavement
- N 53° E 77.93' - Set P.K. Nail & Macomb Co. Remon. Tag in Concrete Slope
- S 32° E 47.89' - Set P.K. Nail & Macomb Co. Remon. Tag in Concrete Slope
- S 51° E 60.95' - Found "+" in Station 20+00 East Edge Northbound M-53 Pavement
- S 67° W 44.60' - Found SE Face S'y Concrete Pillar M-59 Bridge
- N 24° W 66.91' - Found NE Face N'y Concrete Pillar M-59 Bridge

The selected location is accepted by me and is generally accepted by professional surveyors as the best available evidence of the position of the original corner.

Signed by Randy J. Kolehouse Date 11/14/97
 Surveyor's Michigan License No. 25854

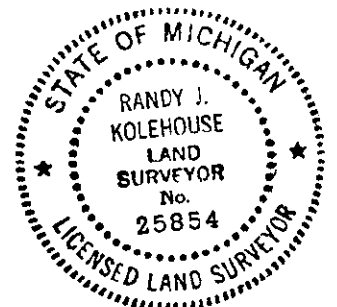

753