

LAND CORNER RECORDATION CERTIFICATE
 Filing Requirement of Act 74, Mich. P.A. 1970

SURVEY &
 REMONUMENTATION

For corners in

	MACOMB (County)	Located in: City of Sterling Heights	Corner Code #
1. Public Land Survey		T <u>2N</u> R <u>12E</u>	<u>I-2</u>
		T _____ R _____	_____
		T _____ R _____	_____
		T _____ R _____	_____
2. Property Controlling in Section	S _____	T _____ R _____	_____
	S _____	T _____ R _____	_____
3. Miscellaneous Property in Sec.	S _____	T _____ R _____	_____
	S _____	T _____ R _____	_____

APR 07 1998

SECTION

Register of Deeds Stamp & File Number


4. Lot No. _____, Recorded Plat _____
 5. Private Claims _____

I, Randy Kolehouse, in a field survey on September 17, 19 97, do hereby certify that under requirements of P.A. 74 Michigan P.A. of 1970, the corner points mentioned in lines 1 and 2 above were in conformance with regulations and rules therefore as required in the current manual of survey instructions of the United States Department of the Interior, Bureau of Land Management or by a decree of a Court of Law and/or that the corner points mentioned in lines 3, 4 and 5 above were in conformance with the rules of the Michigan Board of Land Surveyors or by a Decree of a Court of Law; established, re-established, monumented, re-monumented, recovered, found as expressed below:

NOTE: Not more than 4 corners, all in the same town and range, may be recorded on this certificate.

A. Description of original monument and accessories and/or subsequent restoration:

I-2	1817	G.L.O. Notes	Wampler	N/A	Post
	1952	Green Meadows Sub. No. 1 L. 27 P. 10	McIlveen	#1706	N/A
	1955	Dresden Village Sub. L. 34 P. 21	Lehner	#5787	N/A
	1978	MDOT R/W Drawings	N/A	N/A	N/A
	N/A	M.C. Tax Maps	N/A	N/A	N/A

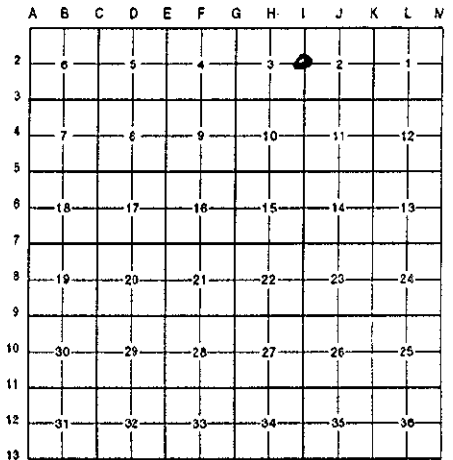

N/A ACCEPTED BY THE MACOMB COUNTY SURVEY PE:
 N/A GROUP AS THE OFFICIAL CORNER UNDER MICHIG
 N/A PUBLIC ACT 345 OF 1990 AT A MEETING IIE
 N/A ON 11/14/97

William E. Soderberg
 WILLIAM E. SODERBERG, P.S., CHAIRMAN

B. Description of corner evidence found and/or method applied in restoring or reestablishing corner:

I-2 This corner falls in the C/L median of M-53. No monumentation has been found in the field. Reset corner using Green Meadows Subdivision No. 1 L. 27 P. 10 and Dresden Village Sub. L. 34 P. 21 using monumentation found along Erdmann Road.

Measure North 3287.56' to I-1 (G.L.O. = 3417.5')
 Measure South 2662.08' to I-3 (G.L.O. = 2640.0') (Green Meadows Sub. No. 1 = 2660.46')


C. Description of monument for corner and accessories established to perpetuate locating the position of the corner:

I-2 I set a 4" x 36" concrete monument with a 1/2" x 36" rebar w/2" diameter aluminum cap stamped "Macomb County Monument MI Act 345 #25854."

- N 17° W 121.23' - Set P.K. Nail & Macomb Co. Remon. Tag in Top Wood Guard Post
- N 85° W 45.11' - Set P.K. Nail & Macomb Co. Remon. Tag in Top Wood Guard Post
- S 25° W 126.88' - Set P.K. Nail & Macomb Co. Remon. Tag in Top Wood Guard Post
- S 88° E 57.73' - Set P.K. Nail & Macomb Co. Remon. Tag in Asphalt Shoulder Northbound M-53
- N 85° W 8.39' = Set P.K. Nail & Macomb Co. Remon. Tag in Asphalt Shoulder Southbound M-53

The selected location is accepted by me and is generally accepted by professional surveyors as the best available evidence of the position of the original corner.

Signed by Randy J. Kolehouse Date 11/14/97
 Surveyor's Michigan License No. 25854

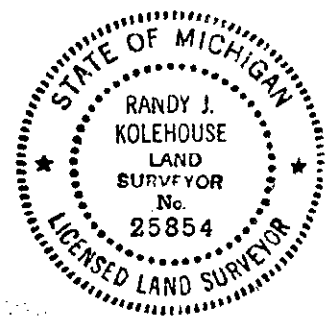

754