B997863

For corne	vo in		Filing Requirement of Act 74, Mich. P.A. 1970						0205022 88 0.02					
MAC						1		CARMI	114	SAE	IAUG	Н		
IVIACO	(County)		Located	In:	Corner Code ##			REGIS	TER	OF D	EED?	3		
	100011177		STER	RLING TWP.				HACO!	49 C	OUNT	Y. M	Ι		
1. Public	Land Survey		⊤ 2N	R 12E	I-3			-			•	_		
	,			_ R	TO THE REAL PROPERTY OF THE PARTY OF THE PAR									
				_ R				004	04	Ana)	* ^			
				_ R			LIBEI	061	LO.	102	13			
2. Prope	rty Controlling	s		_ R										
in Sec				_ R		}								
3. Misce	llaneous			_ R		Regi	ster of	Doods	Stam		Sila M	umb	~~	
Prope	rty in Sec.			_ R		negi	SIGI VI	Deeds	Stani	par	IIG IA	unio	31	
BRUCE ANTCLIFF , in a field survey on							4 7- 5 18- 7 19- 9 19-	17-	9	; — — :	15	-11 -14 -23	13	
•							10 -30		 -2 8	' '	27—	-2'6 	25- 	
	ot more than 4 n this certificate		ill in the sa	ame town ar	nd range, may be recorded	d	11 12 — 31 13	32	33	 	34	-35	36	
			nt and acc	essories and	d/or subsequent restoratio	n:								
GLO - PO	OST; NO WITS REMA	AIN						>	: 1	\$ X	1		131	
	1958) - REINFORCIN	G ROD								m U	ì		3	
	N, NORTH, 60.00' N EDGE OF MH, SO	UTH. 24.35'						1	\ \(\)	ប្ត្រ			ıξl	
	986) L4080.P892- PK		HALT					٤	3 E	Ϋ́		_	HAIRMAN	

FORM NAIL E FACE UTIL. POLE, SOUTH, 50.70' FORM NAIL E FACE UTIL. POLE, NW, 61.26' FORM NAIL SE FACE GUY POLE, NE, 114.73'


1/2" BAR IN MON BOX, WEST, 1829.00"

B. Description of corner evidence found and/or method applied in restoring or reestablishing corner:

FOUND PK NAIL IN ASPHALT ROADWAY

FOUND AND VERIFIED THREE OF THE ABOVE WITNESSES.

MDOT (1979) MEASURED 2667.36' TO \$1/4 SEC. 2; WE MEASURED 2667.05'

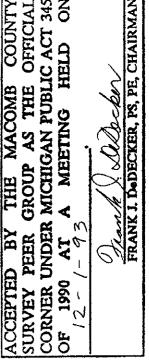

OF MICHIG

BRUCE ANTCLIFF

SURVEYOR No 2582€

TAND

C. Description of monument for corner and accessories established to perpetuate locating the position of the corner:

SET MACOMB COUNTY REMONUMENTATION MARKER AND CAP #25826 IN NEW MON BOX. WITNESSES

FOUND FORM NAIL E FACE UTIL POLE, SOUTH, 50.72' FOUND FORM NAIL E FACE UTIL POLE, N30W, 61.20' FOUND FORM NAIL SE FACE GUY POLE, N81E, 114.74' TOP CENTER OF FIRE HYDRANT, N42E, 100.09'

The selected location is accepted by me and is generally accepted by Professional Surveyors as

the best available evidence of the position of the original corner.

Surveyor's Michigan License No.

_ Date 12-9-93

25826

APPROVED BY MICHIGAN STATE BOARD OF LAND SURVEYORS, JAN. 28, 1971

FRED

REVISED MAY 14, 1975 REVISED JAN., 1983