

SURVEY & REMONUMENTATION

C152259

APR 28 1995

LAND CORNER RECORDATION CERTIFICATE

Filing Requirement of Act 74, Mich. P.A. 1970

34 DEC 14 AM 10:54

or corners in
MACOMB
(County)

	Located In:	Sterling Township	Corner Code #
Public Land Survey	T <u>2N</u>	R <u>12E</u>	<u>1-6</u>
	T _____	R _____	_____
	T _____	R _____	_____
	T _____	R _____	_____
Property Controlling in Section	S _____	T _____	R _____
Miscellaneous Property in Sec.	S _____	T _____	R _____


MICHIGAN
REGISTER OF DEEDS
MACOMB COUNTY, MI

LIBER 6527 PAGE 836

Register of Deeds Stamp & File Number

Lot No. _____, Recorded Plat _____
Private Claims _____

Randy Kolehouse, in a field survey on June 29, 19 94,
I hereby certify that under requirements of P.A. 74, Michigan P.A. of 1970, the corner points mentioned
in lines 1 and 2 above were in conformance with regulations and rules therefore as required in the
current manual of survey instructions of the United States Department of the Interior, Bureau of Land
Management or by a decree of a Court of Law and/or that the corner points mentioned in lines 3, 4 and 5
above were in conformance with the rules of the Michigan Board of Land Surveyors or by a Decree of a
Court of Law; established, re-established, monumented, re-monumented, recovered, found as
expressed below:

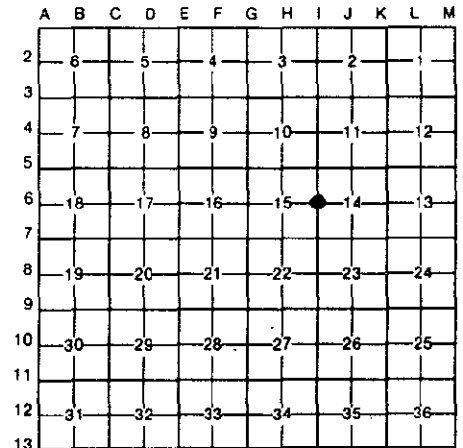

NOTE: Not more than 4 corners, all in the same town and range, may be recorded on this certificate.

Description of original monument and accessories and/or subsequent restoration:

6	1817	G.L.O.	Notes	Wampler	NA	Post
	1978	L.C.R.C.	L. 3027 P. 554	Coulter	#14760	PK Nail
	NA	MCRC	File #74	NA	NA	Wood Stake 3" Down

Description of corner evidence found and/or method applied in restoring or reestablishing corner:

3 Found 1/2" drill hole in pavement center line Dodge Park Drive at NE corner of Stevenson High School property on line of occupation E-W.

L.C.R.C. L. 3027 P. 554
PK in D.E. Pole E 52.42'
PK in D.E. Pole SE 96.50'
PK in D.E. Pole W 50.80'

ACCEPTED BY THE MACOMB COUNTY SURVEY PEER
GROUP AS THE OFFICIAL CORNER UNDER MICHIGAN
PUBLIC ACT 345 OF 1990 AT A MEETING HELD
ON 8-30-94
William E. Soderberg
WILLIAM E. SODERBERG, P.S., CHAIRMAN

Measure S. 2615.23 to I-7 (G.L.O. 2640)
Measure N. 2899.53 to I-5 (G.L.O. 2640)

Description of monument for corner and accessories established to perpetuate locating the position of the corner:

3 I set a 3/4" x 24" Iron Rod w/2" diameter aluminum cap stamped "Macomb County Monument MI Act 345 #25854" and also set Monument Box.

PK with Tag N Side Util. Pole N 84° W 50.72'
NE Cor. Brick Sign Stevenson High School S 33° W 156.28'
PK with Tag W Side Util. Pole S 27° E 96.50'
Nail with Tag N Side Util. Pole S 85° E 52.48'



The selected location is accepted by me and is generally accepted by professional surveyors as the best available evidence of the position of the original corner.

Recorded by Randy J. Kolehouse Date 10/14/94
Surveyor's Michigan License No. 25854