

SURVEY & REMONUMENTATION

APR 28 1995

C152260

COMMISSION LAND CORNER RECORDATION CERTIFICATE

Filing Requirement of Act 74, Mich. P.A. 1970

94 DEC 14 AM 10:54

or corners in
MACOMB
(County)

Located In: Sterling Township Corner Code ##

Public Land Survey	T <u>2N</u> R <u>12E</u>	<u>1-7</u>
	T _____ R _____	_____
	T _____ R _____	_____
	T _____ R _____	_____
Property Controlling in Section	S _____ T _____ R _____	_____
Miscellaneous Property in Sec.	S _____ T _____ R _____	_____


REGISTRY
MACOMB COUNTY, MI

LIBER **6527** PAGE **837**

Register of Deeds Stamp & File Number

Lot No. _____, Recorded Plat _____
Private Claims _____

Randy Kolehouse, in a field survey on June 29, 19 94,
I hereby certify that under requirements of P.A. 74, Michigan P.A. of 1970, the corner points mentioned in lines 1 and 2 above were in conformance with regulations and rules therefore as required in the current manual of survey instructions of the United States Department of the Interior, Bureau of Land Management or by a decree of a Court of Law and/or that the corner points mentioned in lines 3, 4 and 5 above were in conformance with the rules of the Michigan Board of Land Surveyors or by a Decree of a Court of Law; established, re-established, monumented, re-monumented, recovered, found as expressed below:

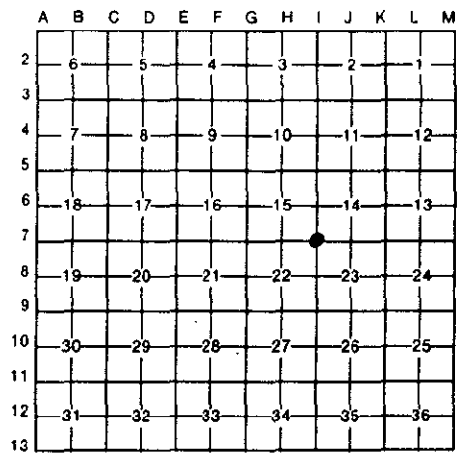

NOTE: Not more than 4 corners, all in the same town and range, may be recorded on this certificate.

Description of original monument and accessories and/or subsequent restoration:

7	1817	G.L.O.	Notes	Wampler	NA	Post
	1977	L.C.R.C.	L. 2879 P. 825	McMahon	#4018	1/2" Iron Pipe
	1978	L.C.R.C.	L. 3027 P. 554	Coulter	#14760	3/4" Pipe

Description of corner evidence found and/or method applied in restoring or reestablishing corner:

- 7 Found 1/2" pipe (bent) at center line intersection of 17 Mile and Doge Park Drive.
- | | |
|--------------------------------------|--------------------------------|
| L.C.R.C. L. 2879 P. 825 | L.C.R.C. L. 3027 P. 554 |
| Nail in P. Pole N 45° W 61.0' | PK Nail in G. Pole SE 70.35' |
| Nail in Stop Lt. Pole S 40° E 69.80' | PK Nail in D.E. Pole SW 81.17' |
| Center of M.H. N 80° W 19.22' | PK Nail in D.E. Pole NW 61.32' |

- Measure N 2615.23 to I-6 (G.L.O. 2640)
- Measure W 2650.87 to H-7 (G.L.O. 2609.6)
- Measure E 2707.33' to J-7 (G.L.O. 2654.5)

Description of monument for corner and accessories established to perpetuate locating the position of the corner:

- 7 I replaced the found 1/2" pipe with a 3/4" x 24" Iron Rod w/2" diameter aluminum cap stamped "Macomb County Monument MI Act 345 #25854," also set Monument Box.
- Nail with Tag S'y Side of P. Pole N 31° W 61.00'
 - Center Line of M.H. N 80° W 19.22'
 - PK Nail NW'y Face D.E. Pole S 48° W 81.49'
 - Nail with Tag NW'y Face Stop Lt. Pole S 34° E 69.80'

ACCEPTED BY THE MACOMB COUNTY SURVEY PEER GROUP AS THE OFFICIAL CORNER UNDER MICHIGAN PUBLIC ACT 345 OF 1990 AT A MEETING HELD ON 9-20-94

William E. Soderberg
WILLIAM E. SODERBERG, P.S., CHAIRMAN



The selected location is accepted by me and is generally accepted by professional surveyors as the best available evidence of the position of the original corner.

Surveyed by Randy J Kolehouse Date 10/14/99
Surveyor's Michigan License No. 25854