

**LAND CORNER RECORDATION CERTIFICATE**  
 Filing Requirement of Act 74, Mich. P.A. 1970

For corners in

MACOMB (County)	Located in:	City of Sterling Heights	Corner Code #
1. Public Land Survey	T <u>2N</u>	R <u>12E</u>	<u>I-11</u>
	T _____	R _____	_____
	T _____	R _____	_____
	T _____	R _____	_____
2. Property Controlling in Section	S _____	T _____	R _____
	S _____	T _____	R _____
3. Miscellaneous Property in Sec.	S _____	T _____	R _____
	S _____	T _____	R _____

REGISTERED  
 RECONSTITUTION

MAR 25 1999


SECTION

Register of Deeds Stamp & File Number

4. Lot No. \_\_\_\_\_, Recorded Plat \_\_\_\_\_  
 5. Private Claims \_\_\_\_\_

I, Bruce Antcliff, in a field survey on September 2 19 98, do hereby certify that under requirements of P.A. 74 Michigan P.A. of 1970, the corner points mentioned in lines 1 and 2 above were in conformance with regulations and rules therefore as required in the current manual of survey instructions of the United States Department of the interior, Bureau of Land Management or by a decree of a Court of Law and/or that the corner points mentioned in lines 3, 4 and 5 above were in conformance with the rules of the Michigan Board of Land Surveyors or by a Decree of a Court of Law; established, re-established, monumented, re-monumented, recovered, found as expressed below:

NOTE: Not more than 4 corners, all in the same town and range, may be recorded on this certificate.

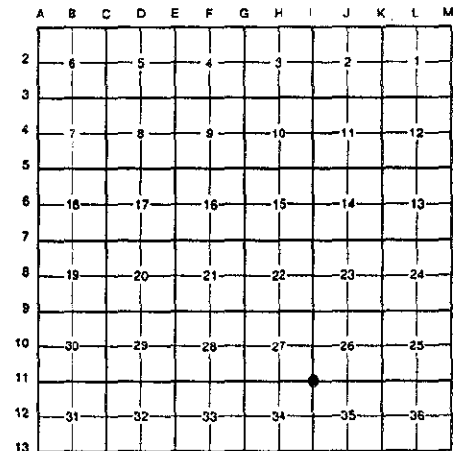

A. Description of original monument and accessories and/or subsequent restoration:

I-11	1817	G.L.O. Notes	Wampler	N/A	Post
	1926	Sterling Park Sub. L. 11 P. 47	Jerome	N/A	N/A
	1928	MCRC Wit. File	N/A	N/A	Set "X" on Conc.
	1965	Willow Woods Sub. L. 56 P. 22	Lehner	#5787	N/A
	1966	Seville Gardens Sub. L. 56 P. 34	Lehner	#5787	N/A
	1987	Cert. Survey L. 6329 P. 240	Stephens	#29252	Fnd. Iron Bar in Mon. Box
	1996	L.C.R.C. L. 6900 P. 881	Fenn	#23505	3/4" Bar in Mon. Box

B. Description of corner evidence found and/or method applied in restoring or reestablishing corner:

I-11 I found a 5/8" rebar in a monument box at the C/L intersection of 15 Mile Road (conc.) running East and West and Dodge Park Road (conc.) running North which checks with Sterling Park Sub. & Seville Gardens and with the following witnesses:

- L.C.R.C. L 6900 P. 881
- N 45° E 66.39 Nail NW Face Traffic Signal Pole (m. 66.38')
- S 67° E 90.72 PK Nail SW Face U.P. (m. 90.75')
- S 43° W 61.48' Nail SE Face Traffic Signal Pole (m. 61.36')
- N 55° W 65.27' Nail SW Face Traffic Signal Pole (m. 65.34')

ACCEPTED BY THE MACOMB COUNTY SURVEY PEER GROUP AS THE OFFICIAL CORNER UNDER MICHIGAN PUBLIC ACT 345 OF 1990 AT A MEETING HELD ON 10/27/98  
William E. Soderberg  
 WILLIAM E. SODERBERG, P.S., CHAIRMAN


- Measure North 2685.06' to I-10 (G.L.O. = 2640.0') (Sterling Park Sub. = 2684.97')
- Measure East 2716.69' to J-11 (G.L.O. = 2702.7') (Cert. Surv. L. 6329 P. 240 = 2716.50')
- Measure South 2622.6' to I-12 (G.L.O. = 2640.0') (Seville Gardens Sub. Calc. = 2622.6')
- Measure West 2667.04' to H-11 (G.L.O. = 2574.0') (Seville Gardens Sub. Calc. = 2666.55')

C. Description of monument for corner and accessories established to perpetuate locating the position of the corner:

I-11 I replaced the found 5/8" rebar with a 3/4" x 24" iron rod w/2" diameter aluminum cap stamped "Macomb County Monument MI Act 345 #25826" in an existing monument box.

S 61° E 90.75'	Set Mag. Nail with MCRC Remon Tag in SW'ly Face of Utility Pole
N 68° E 88.08'	Set Mag. Nail with MCRC Remon Tag in NW'ly Face of Utility Pole
N 50° E 66.38'	Found P.K. Nail with Tag #23505 in NW'ly Face of Traffic Pole
N 49° W 65.34'	Set Mag. Nail with MCRC Remon Tag in SW'ly Face of Utility Pole
S 49° W 52.18'	Found P.K. Nail in SE Face of Utility Pole (No Wires)
S 48° W 61.35'	Set Mag. Nail with MCRC Remon Tag in SE Face Utility Pole

The selected location is accepted by me and is generally accepted by professional surveyors as the best available evidence of the position of the original corner.

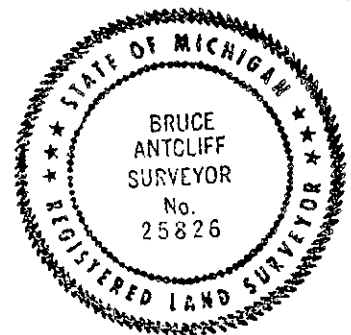

Signed by Bruce Antcliff  
 EARTH TECH

Date 11-25-98

Surveyor's Michigan License No. 25826

*[Handwritten initials]*

*[Handwritten number 264]*