


C0863650 LIBER:08565 PAGE:889 09:45A 01/19/1999
 CARMELLA SABAUGH-MACOMB COUNTY, MI REG/DEEDS
 LAND CORNER RECORDATION CERTIFICATE
 Filing Requirement of Act 74, Mich. P.A. 1970

For corners in

	Located in:	City of	Corner Code #
<u>MACOMB</u> (County)		<u>Sterling Heights</u>	
1. Public Land Survey	T <u>2N</u> R <u>12E</u>		<u>I-12</u>
	T _____ R _____		_____
	T _____ R _____		_____
	T _____ R _____		_____
2. Property Controlling in Section	S _____ T _____ R _____		_____
	S _____ T _____ R _____		_____
3. Miscellaneous Property in Sec.	S _____ T _____ R _____		_____
	S _____ T _____ R _____		_____
4. Lot No. _____, Recorded Plat _____			
5. Private Claims _____			

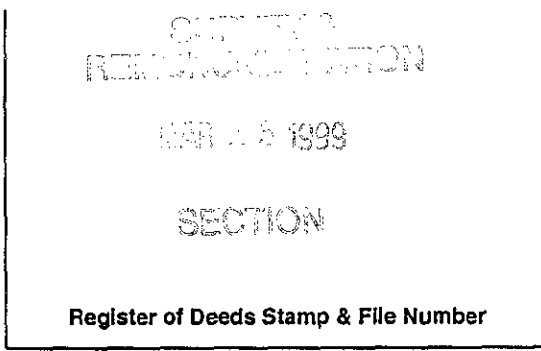

	A	B	C	D	E	F	G	H	I	J	K	L	M
2	6	5	4	3	2	1							
3													
4	7	8	9	10	11	12							
5													
6	13	14	15	16	17	18							
7													
8	19	20	21	22	23	24							
9													
10	25	26	27	28	29	30							
11													
12	31	32	33	34	35	36							
13													

I, Bruce Antcliff, in a field survey on September 11 19 98, do hereby certify that under requirements of P.A. 74 Michigan P.A. of 1970, the corner points mentioned in lines 1 and 2 above were in conformance with regulations and rules therefore as required in the current manual of survey instructions of the United States Department of the interior, Bureau of Land Management or by a decree of a Court of Law and/or that the corner points mentioned in lines 3, 4 and 5 above were in conformance with the rules of the Michigan Board of Land Surveyors or by a Decree of a Court of Law; established, re-established, monumented, re-monumented, recovered, found as expressed below:

NOTE: Not more than 4 corners, all in the same town and range, may be recorded on this certificate.

A. Description of original monument and accessories and/or subsequent restoration:

I-12	1817	G.L.O. Notes	Wampler	N/A	Post
	1966	Seville Garden Sub. L. 56 P. 34	Lehner	#5787	N/A

ACCEPTED BY THE MACOMB COUNTY SURVEY PEER GROUP AS THE OFFICIAL CORNER UNDER MICHIGAN PUBLIC ACT 345 OF 1990 AT A MEETING HELD ON 10/27/98
William E. Soderberg
 WILLIAM E. SODERBERG, P.S., CHAIRMAN

B. Description of corner evidence found and/or method applied in restoring or reestablishing corner:

I-12 This corner falls in the Maple Lane Golf Club property. Calculated the location of this corner using Seville Gardens Subdivision L. 56 P. 34. Using irons found in said Subdivision, set a point at this corner location Record distance 2622.60' South of I-11 on line of irons found. This point is 37.40' West of a line between the opposite Section corners and within 2.5' m/l of the midpoint.

Measure North 2622.6' to I-11 (G.L.O. = 2640.0') (Seville Gardens Sub. = 2622.6')
 Measure South 2629.1' to I-13 (G.L.O. = 2640.0')

C. Description of monument for corner and accessories established to perpetuate locating the position of the corner:

I-12 Set a 3/4" x 24" iron rod w/2" diameter aluminum cap stamped "Macomb County Monument MI Act 345 #25826."

- N 67° W 13.19' Set P.K. Nail with Macomb Tag in S Face 22" Wild Cherry
- N 13° W 44.19' Set P.K. Nail with Macomb Tag in E Face 18" Maple
- N 50° E 56.36' Set P.K. Nail with Macomb Tag in SE Face 20" Elm
- S 15° W 162.94' Set P.K. Nail with Macomb Tag in E Face 10" Ash

SW Corner of a 5' x 9' Concrete Block Storm Drainage Structure 7' E and 2' S

The selected location is accepted by me and is generally accepted by professional surveyors as the best available evidence of the position of the original corner.

Signed by Bruce Antcliff Date 11-25-98
 EARTH TECH

Surveyor's Michigan License No. 25826



805