

LAND CORNER RECORDATION CERTIFICATE

B997866

Filing Requirement of Act 74, Mich. P.A. 1970 83 DEC 22 AM 9:03

For corners in

MACOMB

(County)

Located In:

Corner Code #

STERLING TWP.

- |                                    |   |           |   |            |            |
|------------------------------------|---|-----------|---|------------|------------|
| 1. Public Land Survey              | T | <u>2N</u> | R | <u>12E</u> | <u>J-1</u> |
|                                    | T | _____     | R | _____      | _____      |
|                                    | T | _____     | R | _____      | _____      |
|                                    | T | _____     | R | _____      | _____      |
| 2. Property Controlling in Section | S | _____     | T | _____      | R          |
|                                    | S | _____     | T | _____      | R          |
| 3. Miscellaneous Property in Sec.  | S | _____     | T | _____      | R          |
|                                    | S | _____     | T | _____      | R          |
4. Lot No. \_\_\_\_\_, Recorded Plat \_\_\_\_\_
5. Private Claims \_\_\_\_\_

CARMELLA SABAUGH  
REGISTER OF DEEDS  
MACOMB COUNTY, MI

LIBER 061618216

Register of Deeds Stamp & File Number

I, BRUCE ANTCLIFF, in a field survey on NOVEMBER 22, 19 93,

do hereby certify that under requirements of P.A. 74, Michigan P.A. of 1970, the corner points mentioned in lines 1 and 2 above were in conformance with regulations and rules therefore as required in the current manual of survey instructions of the United States Department of the Interior, Bureau of Land Management or by a decree of a Court of Law and/or that the corner points mentioned in lines 3, 4 and 5 above were in conformance with the rules of the Michigan Board of Land Surveyors or by a Decree of a Court of Law; established, re-established, monumented, re-monumented, recovered, found as expressed below:

NOTE: Not more than 4 corners, all in the same town and range, may be recorded on this certificate.

A. Description of original monument and accessories and/or subsequent restoration:

GLO-Post, NO WITS. REMAIN

MDOT & LCRC (1974) L2500,P800- "X" IN CONCRETE  
TOP OF HYDRANT, S10W, 88.36'  
GUY POLE, S50W, 87.94'  
"X" ON HY-LINE TWR., N05W, 61.78'

MDOT (1988) PK NAIL  
TOP CENTER HYD., SSE, 88.38'  
MDOT N&T IN GUY POLE, SW, 87.96  
"X" SE LEG DE TWR., NNW, 61.75'  
"X" N RIM BELL MH, NE, 52.33'

LCRC (1988) L4369,P431, -SET PK FROM PREV WITS  
TOP CENTER HYD., SSE, 88.38'  
N&T SE FACE GUY POLE, SW, 87.96'  
CHISEL MARK SE LEG DE TWR, NNW, 61.75'  
"X" N RIM BELL MH, NE, 52.33'

LCRC (1989) L4828,P156, -RESET PK FROM WITS.  
TOP CENTER HYD., SSE, 88.38'  
NAIL W/TAG SE FACE GUY POLE, SW, 87.96  
"X" SE LEG DE TWR., NNW, 61.75'  
"X" N RIM BELL MH, NE, 52.33'

LCRC (1990) L4888,P975-5/8" COPPER ROD & CAP  
IN MON BOX  
TOP CENTER HYD., S05W, 88.29'  
N&T SE FACE UTILITY POLE, S45W, 87.88'  
"X" SE LEG DE TWR., N05W, 61.84'  
"X" N RIM BELL MH, N45E, 52.37'  
N&T E FACE PP, N15W, 57.61'

ALL RECORDS INDICATE THAT THIS CORNER IS COMMON TO BOTH T2N, R12E & T3N, R12E.

B. Description of corner evidence found and/or method applied in restoring or reestablishing corner:

FOUND 5/8" COPPER ROD & CAP/MON. BOX

FOUND AND VERIFIED FOUR OF THE ABOVE WITNESSES

	A	B	C	D	E	F	G	H	I	J	K	L	M
2	6	5	4	3	2	1							
3													
4	7	8	9	10	11	12							
5													
6	16	17	16	15	14	13							
7													
8	19	20	21	22	23	24							
9													
10	30	29	28	27	26	25							
11													
12	31	32	33	34	35	36							
13													


ACCEPTED BY THE MACOMB COUNTY SURVEY PEER GROUP AS THE OFFICIAL CORNER UNDER MICHIGAN PUBLIC ACT 345 OF 1990 AT A MEETING HELD ON 12-1-93

*Frank J. DeDecker*  
FRANK J. DEDecker, PS, PE, CHAIRMAN

C. Description of monument for corner and accessories established to perpetuate locating the position of the corner:

SET MACOMB COUNTY REMONUMENTATION MARKER AND CAP #25826 IN EXIST. MON. BOX. WITNESSES

- FND TOP OF HYDRANT, S07W, 88.27
- FND MDOT N&T IN GUY POLE, S46W, 87.88
- FND N&T E FACE P POLE, N14W, 57.57
- FND "+" N RIM BELL MH, N45E, 52.34

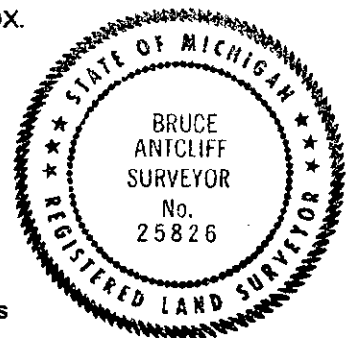

The selected location is accepted by me and is generally accepted by Professional Surveyors as the best available evidence of the position of the original corner.

Signed by Bruce Antcliff Date 12-9-93

Surveyor's Michigan License No. 25826