

**LAND CORNER RECORDATION CERTIFICATE**  
**Filing Requirement of Act 74, Mich. P.A. 1970**

B997867

For corners in

<u>MACOMB</u> <small>(County)</small>	Located In:	Corner Code <del>##</del>
	<b>STERLING TWP.</b>	
1. Public Land Survey	T <u>2N</u> R <u>12E</u>	<u>J-3</u>
	T _____ R _____	_____
	T _____ R _____	_____
	T _____ R _____	_____
2. Property Controlling in Section	S _____ T _____ R _____	_____
	S _____ T _____ R _____	_____
3. Miscellaneous Property in Sec.	S _____ T _____ R _____	_____
	S _____ T _____ R _____	_____
4. Lot No. _____, Recorded Plat _____		
5. Private Claims _____		

LIBER **061610217**

Register of Deeds Stamp & File Number

I, BRUCE ANTCLIFF, in a field survey on NOVEMBER 18, 1993, do hereby certify that under requirements of P.A. 74, Michigan P.A. of 1970, the corner points mentioned in lines 1 and 2 above were in conformance with regulations and rules therefore as required in the current manual of survey instructions of the United States Department of the Interior, Bureau of Land Management or by a decree of a Court of Law and/or that the corner points mentioned in lines 3, 4 and 5 above were in conformance with the rules of the Michigan Board of Land Surveyors or by a Decree of a Court of Law; established, re-established, monumented, re-monumented, recovered, found as expressed below:

A	B	C	D	E	F	G	H	I	J	K	L	M
2	6	5	4	3	2	1						
3									●			
4	7	8	9	10	11	12						
5												
6	18	17	16	15	14	13						
7												
8	19	20	21	22	23	24						
9												
10	30	29	28	27	26	25						
11												
12	31	32	33	34	35	36						
13												

**NOTE: Not more than 4 corners, all in the same town and range, may be recorded on this certificate.**

A. Description of original monument and accessories and/or subsequent restoration:

- GLO-Post, NO WITS, REMAIN
- MCRC-REINFORCING ROD (1958), NO WITS REMAIN
- EDISON (1960)-SET IRON FROM SUBD'N DATA, NO WITS, MEAS. 2670.90' TO NE COR. SEC. 11
- MDOT R/W PLANS (1979)-MEAS. 2667.36' TO NW COR. SEC. 11
- EDISON (1989) -MEAS. 2671.31' TO NE COR. SEC. 11

B. Description of corner evidence found and/or method applied in restoring or reestablishing corner:

- FOUND 1/2" REBAR IN MON BOX
- MEASURED 2667.05' TO NW COR SEC. 11
- MEASURED 2671.14' TO NE COR SEC. 11

93 DEC 22 AM 9: 03


CARMELLA SABAUGH  
REGISTER OF DEEDS  
MACOMB COUNTY, MI

ACCEPTED BY THE MACOMB COUNTY  
SURVEY PEER GROUP AS THE OFFICIAL  
CORNER UNDER MICHIGAN PUBLIC ACT 345  
OF 1990 AT A MEETING HELD ON  
12-1-93

*Frank J. Dadecker*  
FRANK J. DADECKER, P.S., P.E., CHAIRMAN

C. Description of monument for corner and accessories established to perpetuate locating the position of the corner:

- SET MACOMB COUNTY REMONUMENTATION MARKER AND CAP #25826 IN EXIST. MON. BOX
- WITNESSES
- FOUND PK W SIDE PP, N17W, 32.69'
- FOUND PK W SIDE PP, S08W, 52.85'
- TOP CENTER FIRE HYDRANT, N27E, 44.18'
- SET "+" N RIM SAN. MH, S31E, 51.89'

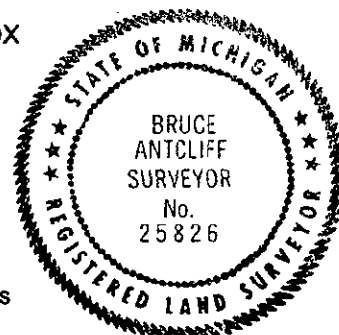

The selected location is accepted by me and is generally accepted by Professional Surveyors as the best available evidence of the position of the original corner.

Signed by Bruce Antcliff Date 12-9-93  
 Surveyor's Michigan License No. 25826