

# SURVEY & REMONUMENTATION

C152261

APR 28 1995

## LAND CORNER RECORDATION CERTIFICATE Filing Requirement of Act 74, Mich. P.A. 1970

94 DEC 14 AM 10:54

For corners in **COMMISSION**

**MACOMB**

(County)

Located In: **Sterling Township** Corner Code **J-5**

Public Land Survey	T	<u>2N</u>	R	<u>12E</u>	<u>J-5</u>
	T		R		
	T		R		
	T		R		
Property Controlling in Section	S		T		
Miscellaneous Property in Sec.	S		T		

MACOMB COUNTY REGISTER OF DEEDS

LIBER **6527** PAGE **838**

Register of Deeds Stamp & File Number

Lot No. \_\_\_\_\_, Recorded Plat \_\_\_\_\_  
Private Claims \_\_\_\_\_

	A	B	C	D	E	F	G	H	I	J	K	L	M
2	6	5	4	3	2	1							
3													
4	7	8	9	10	11	12							
5													
6	18	17	16	15	14	13							
7													
8	19	20	21	22	23	24							
9													
10	30	29	28	27	26	25							
11													
12	31	32	33	34	35	36							
13													

Randy Kolehouse, in a field survey on June 30, 1994, hereby certify that under requirements of P.A. 74, Michigan P.A. of 1970, the corner points mentioned in lines 1 and 2 above were in conformance with regulations and rules therefore as required in the current manual of survey instructions of the United States Department of the Interior, Bureau of Land Management or by a decree of a Court of Law and/or that the corner points mentioned in lines 3, 4 and 5 above were in conformance with the rules of the Michigan Board of Land Surveyors or by a Decree of a Court of Law; established, re-established, monumented, re-monumented, recovered, found as expressed below:

**OTE: Not more than 4 corners, all in the same town and range, may be recorded on this certificate.**

Description of original monument and accessories and/or subsequent restoration:

J-5	1817	G.L.O.	Notes	Wampler	NA	Post
	1974	Survey		Avey	#15396	NA
	1989	Detroit Edison Survey		Young	#25885	Monument

Description of corner evidence found and/or method applied in restoring or reestablishing corner:

-5 Found concrete monument on south line of Takoma Park Sub. L. 46 P. 24. Monument is on line of fence running east and west.


Detroit Edison Survey  
PK S. Face D.E. Co. Pole N 89° E 28.05'  
Center Line Steel Fence Post SE Cor. Lot 68 East 26.29'  
Center Line Steel Fence Post SW Cor. Lot 68 West 32.65'  
  
Measure W 2692.79 to I-5 (G.L.O. 2640)  
Measure E 2630.11 to K-5 (Det. Ed. 2631.00) (G.L.O. 2640)

ACCEPTED BY THE MACOMB COUNTY SURVEY PEER GROUP AS THE OFFICIAL CORNER UNDER MICHIGAN PUBLIC ACT 345 OF 1990 AT A MEETING HELD ON 9-20-94  
William E. Soderberg  
WILLIAM E. SODERBERG, P.S., CHAIRMAN

Description of monument for corner and accessories established to perpetuate locating the position of the corner:

-5 I placed a 2" diameter aluminum cap stamped "Macomb County Monument MI Act 345 #25854" on an existing concrete monument.

PK with Washer S Face P. Pole S 86° E 28.04'  
Center Line Fence Post SE Cor. Lot 68 S 85° E 26.25'  
SW Cor. Gar. #12754 Denter N 8° E 24.81'  
SE Cor. Gar. #12742 Denter N 52° W 43.11'  
Center Line Fence Post SW Cor. Lot 68 N 85° W 32.65'

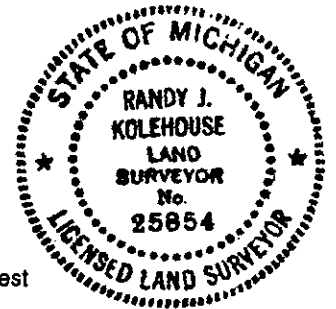

The selected location is accepted by me and is generally accepted by professional surveyors as the best available evidence of the position of the original corner.

Signed by Randy J. Kolehouse Date 10/14/94  
Surveyor's Michigan License No. 25854