

# SURVEY & REMONUMENTATION

C152262

APR 28 1995

## LAND CORNER RECORDATION CERTIFICATE Filing Requirement of Act 74, Mich. P.A. 1970

94 DEC 16 AM 10:54

COMMISSION

MICHIGAN  
DEEDS  
RECORDS  
DIVISION  
LANSING, MI

or corners in  
MACOMB

(County)

Located In: Sterling Township Corner Code #J-7

Public Land Survey	T 2N	R 12E	J-7
	T	R	
	T	R	
	T	R	
Property Controlling in Section	S	T	R
Miscellaneous	S	T	R
Property in Sec.	S	T	R

LIBER 6527 PAGE 839

Register of Deeds Stamp & File Number

Lot No. \_\_\_\_\_, Recorded Plat \_\_\_\_\_  
Private Claims \_\_\_\_\_

	A	B	C	D	E	F	G	H	I	J	K	L	M
2	6	5	4	3	2	1							
3													
4	7	8	9	10	11	12							
5													
6	18	17	16	15	14	13							
7													
8	19	20	21	22	23	24							
9													
10	30	29	28	27	26	25							
11													
12	31	32	33	34	35	36							
13													

Randy Kolehouse, in a field survey on July 21, 1994,  
I hereby certify that under requirements of P.A. 74, Michigan P.A. of 1970, the corner points mentioned in lines 1 and 2 above were in conformance with regulations and rules therefore as required in the current manual of survey instructions of the United States Department of the Interior, Bureau of Land Management or by a decree of a Court of Law and/or that the corner points mentioned in lines 3, 4 and 5 above were in conformance with the rules of the Michigan Board of Land Surveyors or by a Decree of a Court of Law; established, re-established, monumented, re-monumented, recovered, found as expressed below:

**NOTE: Not more than 4 corners, all in the same town and range, may be recorded on this certificate.**

Description of original monument and accessories and/or subsequent restoration:

7	1817	G.L.O.	Notes	Wampler	NA	Post
		Executive Heights Sub.	L. 55 P. 44	NA	NA	NA
		Silver Maple Sub.	L. 66 P. 32	NA	NA	NA
		MCRC Road Plans		NA	NA	Corner Shown (No Desc.)
	1979	Survey	L. 3338 P. 577	Nicolaescu	#22705	NA

Description of corner evidence found and/or method applied in restoring or reestablishing corner:

7 Set point for corner using plat corners found along the north line of Executive Heights Sub. L 55 P. 44. This pointchecks the distance to K-7 as shown on MCRC Plans for Schoenherr Road. The S 1/4 corner shown on Silver Maple Sub.L. 66 P. 32 appears to be 1.0 ± North of this location. This location also checks closely to Cert. Survey L. 3338 P. 577.


Measure E 2644.76 to K-7 (MCRC 2644.76) (G.L.O. 2657.8)  
Measure W 2707.33 to I-7 (G.L.O. 2657.8)

ACCEPTED BY THE MACOMB COUNTY SURVEY PEER GROUP AS THE OFFICIAL CORNER UNDER MICHIGAN PUBLIC ACT 345 OF 1990 AT A MEETING HELD ON 9/20/94  
William E. Soderberg  
WILLIAM E. SODERBERG, P.S., CHAIRMAN

Description of monument for corner and accessories established to perpetuate locating the position of the corner:

7 I placed a 3/4" x 24" Iron Rod w/2" diameter aluminum cap stamped "Macomb County Monument MI Act 345 #25854," also set Monument Box.

- PK & Macomb Co. Remon. Tag in W Face P. Pole S 55° E 103.97'
- PK & Macomb Co. Remon. Tag in E Face P. Pole S 33° W 59.52'
- Punch Mark on W Side Gate Post N 37° E 71.19'
- \*+ Cut N Rim M.H. S 06° E 35.58'

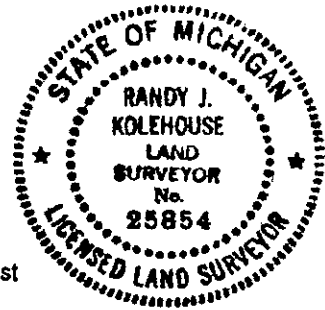

The selected location is accepted by me and is generally accepted by professional surveyors as the best available evidence of the position of the original corner.

Witnessed by Randy J. Kolehouse  
Surveyor's Michigan License No. 25854

Date 10/14/94