

LAND CORNER RECORDATION CERTIFICATE
Filing Requirement of Act 74, Mich. P.A. 1970

**SURVEY &
REMONUMENTATION**

FEB 27 1997

COMMISSION

Register of Deeds Stamp & File Number

or corners in

MACOMB Located in: City of _____ Corner Code # _____
(County) Sterling Heights

Public Land Survey T 2N R 12E _____ J-9
T _____ R _____
T _____ R _____
T _____ R _____

Property Controlling S _____ T _____ R _____
in Section S _____ T _____ R _____


Miscellaneous S _____ T _____ R _____

Property in Sec. S _____ T _____ R _____

Lot No. _____, Recorded Plat _____
Private Claims _____

Randy Kolehouse, in a field survey on May 28 19 96,
hereby certify that under requirements of P.A. 74 Michigan P.A. of 1970, the corner points mentioned
lines 1 and 2 above were in conformance with regulations and rules therefore as required in the
rent manual of survey instructions of the United States Department of the interior, Bureau of Land
agement or by a decree of a Court of Law and/or that the corner points mentioned in lines 3, 4 and 5
ove were in conformance with the rules of the Michigan Board of Land Surveyors or by a Decree of a
urt of Law; established, re-established, monumented, re-monumented, recovered, found as
pressed below:

**NOTE: Not more than 4 corners, all in the same town and range, may be recorded
on this certificate.**

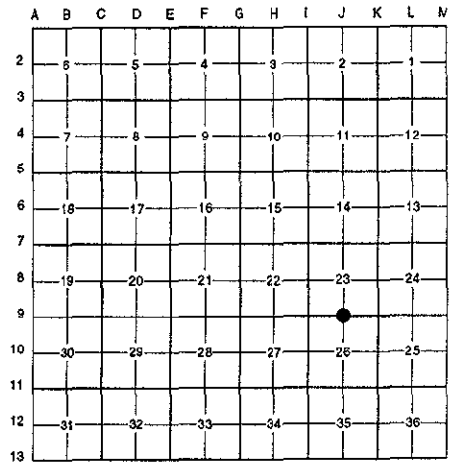

Description of original monument and accessories and/or subsequent restoration:

1817	G.L.O. Notes	Wampler	N/A	Set Post
N/A	MCRC File No. 108	N/A	N/A	Wood Stake 5" Down
1967	MCRC File No. 108	N/A	N/A	"T" Iron
1969	MCRC File No. 108	N/A	N/A	"T" Iron
1974	Cert. Survey L. 2486 P. 510	Kobs	#14097	1/2" Iron in Monument Box

Description of corner evidence found and/or method applied in restoring or reestablishing corner:

I found a 1/2" rebar in a monument box 1' ± below grade at the C/L median of 16 Mile Road (Metropolitan Parkway)
running East and West on the West side of a Detroit Edison power line corridor running North and South which checks with
witnesses listed below. No witnesses remain from Wampler's G.L.O. notes or from the Macomb County Road Commission
non-dated or 1967 records.

1969 Macomb County Road Commission Records
North 102.00' - Concrete Monument (m. 101.88')
Northeast 131.40' - Chisled Mark 2nd Leg of High Tower (m. 131.26')

Cert. Survey L. 2486 P. 510
N 28.66' - Back of Curb (m. 28.65')
S 28.66' - Back of Curb (m. 28.67')
E 49.47' - Back of Curb of Turn Lane (m. 49.45')

Measure East 2707.75' to K-9 (G.L.O. = 2669.04')
Measure West 2646.66' to I-9 (G.L.O. = 2669.04')

ACCEPTED BY THE MACOMB COUNTY SURVEY PEER
GROUP AS THE OFFICIAL CORNER UNDER MICHIGAN
PUBLIC ACT 345 OF 1990 AT A MEETING HELD
ON 9-17-96
William E. Soderberg
WILLIAM E. SODERBERG, P.S., CHAIRMAN


Description of monument for corner and accessories established to perpetuate locating the position of the corner:

I replaced the 1/2" rebar with a 3/4" x 24" iron rod w/2" diameter aluminum cap stamped "Macomb County Monument MI
Act 345 #25854" in an existing monument box.

N 42° E 144.97' - Found "+" W Side Conc. Pier for SW Leg Tower #1 888
S 40° E 129.39' - Set Nail and Macomb Co. Remon. Tag in SW Face New P. Pole
S 24° W 97.40' - Set Nail and Macomb Co. Remon. Tag in E Face P. Pole
North 93.46' - Set Nail and Macomb Co. Remon. Tag in E Face T. Pole

The selected location is accepted by me and is generally accepted by professional surveyors
as the best available evidence of the position of the original corner.

Recorded by Randy J. Kolehouse Date 11/19/96
Surveyor's Michigan License No. 25854

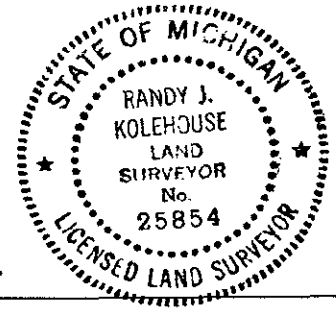

1041