

SURVEY & REMONUMENTATION

APR 28 1995

LAND CORNER RECORDATION CERTIFICATE
Filing Requirement of Act 74, Mich. P.A. 1970

C152263

COMMISSION

or corners in MACOMB <small>(County)</small>	Located In:	Sterling Township	Corner Code # <u> K-7 </u>
Public Land Survey	T <u>2N</u> R <u>12E</u>	_____	_____
	T _____ R _____	_____	_____
	T _____ R _____	_____	_____
	T _____ R _____	_____	_____
Property Controlling in Section	S _____ T _____ R _____	_____	_____
Miscellaneous	S _____ T _____ R _____	_____	_____
Property in Sec.	S _____ T _____ R _____	_____	_____

94 DEC 14 AM 10:54


REG. DEEDS
MACOMB COUNTY, MI

LIBER 6527 PAGE 840

Register of Deeds Stamp & File Number

Lot No. _____, Recorded Plat _____
Private Claims _____

Randy Kolehouse in a field survey on July 21, 1994,
hereby certify that under requirements of P.A. 74, Michigan P.A. of 1970, the corner points mentioned
lines 1 and 2 above were in conformance with regulations and rules therefore as required in the
current manual of survey instructions of the United States Department of the Interior, Bureau of Land
Management or by a decree of a Court of Law and/or that the corner points mentioned in lines 3, 4 and 5
above were in conformance with the rules of the Michigan Board of Land Surveyors or by a Decree of a
Court of Law; established, re-established, monumented, re-monumented, recovered, found as
expressed below:

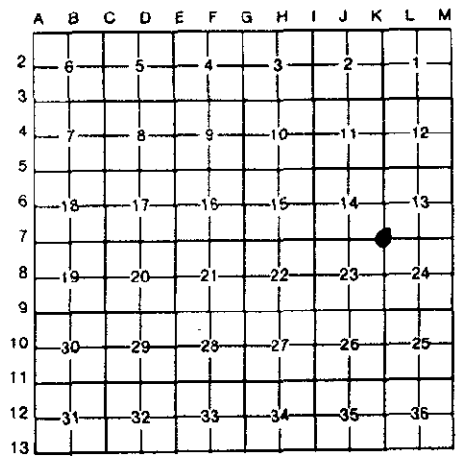

NOTE: Not more than 4 corners, all in the same town and range, may be recorded on this certificate.

Description of original monument and accessories and/or subsequent restoration:

(-7	1817	G.L.O.	Notes	Wampler	NA	Post
	1976	Det. Ed. Survey	SE723-16	Kinsvater	NA	Shows Corner (No Desc.)
		MCRC	Road Plans	NA	NA	Shows Corner (No Desc.)

Description of corner evidence found and/or method applied in restoring or reestablishing corner:

(-7 Found concrete monument 200' ± East of N.B. Schoenherr Road per MCRC Road Improvement Plans. Check dist. to J-7 as shown in MCRC Plans.

No witnesses available.

- Measure W 2644.76 to J-7 (MCRC 2644.76) (G.L.O. 2640)
- Measure E 2699.12 to L-7 (G.L.O. 2640)
- Measure N 2659.67 to K-6 (G.L.O. 2640)

ACCEPTED BY THE MACOMB COUNTY SURVEY PEER
GROUP AS THE OFFICIAL CORNER UNDER MICHIGAN
PUBLIC ACT 345 OF 1990 AT A MEETING HELD
ON 9-20-94
William E. Soderberg
WILLIAM E. SODERBERG, P.S., CHAIRMAN

Description of monument for corner and accessories established to perpetuate locating the position of the corner:

- (-7 I placed a 2" diameter aluminum cap stamped "Macomb County Monument MI Act 345 #25854" on the existing concrete monument.
- PK & Macomb Co. Remon. Tag S Side 30" Maple S 77° W 14.27'
 - PK & Macomb Co. Remon. Tag S Side 12" Maple S 46° W 34.18'
 - PK & Macomb Co. Remon. Tag E Side 48" Maple S 13° E 46.40'
 - PK & Macomb Co. Remon. Tag E Side 8" Beech S 35° E 30.11'
 - PK & Macomb Co. Remon. Tag N Side 10" Maple N 60° E 31.19'
 - Iron - Capped Iron #14097 S 5° W 94.97'



The selected location is accepted by me and is generally accepted by professional surveyors as the best available evidence of the position of the original corner.

Recorded by Randy J. Kolehouse Date 10/14/94
Surveyor's Michigan License No. 25854