

**LAND CORNER RECORDATION CERTIFICATE**  
**Filing Requirement of Act 74, Mich. P.A. 1970**

**SURVEY &  
REMONUMENTATION**

FEB 27 1997

COMMISSION

Register of Deeds Stamp & File Number


corners in

MACOMB  
(County)

Located in: City of Sterling Heights Corner Code # \_\_\_\_\_

|                                 |             |              |            |
|---------------------------------|-------------|--------------|------------|
| Public Land Survey              | T <u>2N</u> | R <u>12E</u> | <u>K-9</u> |
|                                 | T _____     | R _____      | _____      |
|                                 | T _____     | R _____      | _____      |
|                                 | T _____     | R _____      | _____      |
| Property Controlling in Section | S _____     | T _____      | R _____    |
| Miscellaneous                   | S _____     | T _____      | R _____    |
| Property in Sec.                | S _____     | T _____      | R _____    |

Lot No. \_\_\_\_\_, Recorded Plat \_\_\_\_\_  
Private Claims \_\_\_\_\_

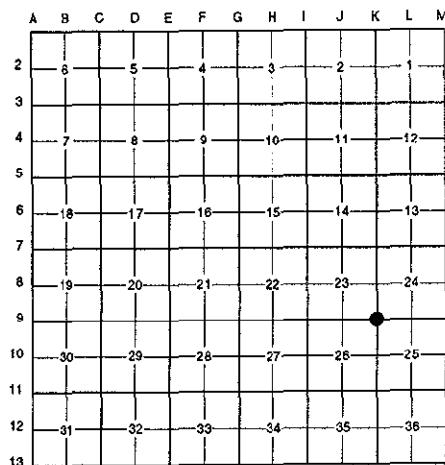

Randy Kolehouse, in a field survey on April 30 19 96,

hereby certify that under requirements of P.A. 74 Michigan P.A. of 1970, the corner points mentioned in lines 1 and 2 above were in conformance with regulations and rules therefore as required in the present manual of survey instructions of the United States Department of the Interior, Bureau of Land Management or by a decree of a Court of Law and/or that the corner points mentioned in lines 3, 4 and 5 above were in conformance with the rules of the Michigan Board of Land Surveyors or by a Decree of a Court of Law; established, re-established, monumented, re-monumented, recovered, found as pressed below:

**NOTE: Not more than 4 corners, all in the same town and range, may be recorded on this certificate.**

Description of original monument and accessories and/or subsequent restoration:

|   |      |                           |         |        |                         |
|---|------|---------------------------|---------|--------|-------------------------|
| 9 | 1817 | G.L.O. Notes              | Wampler | N/A    | Set Post                |
|   | N/A  | MCRC File No. 107         | N/A     | N/A    | Wood Stake              |
|   | 1967 | MCRC File No. 107         | N/A     | N/A    | "T" Iron                |
|   | 1968 | MCRC File No. 107         | N/A     | N/A    | "T" Iron                |
|   | 1969 | MCRC File No. 107         | N/A     | N/A    | Form Pin Iron           |
|   | 1974 | L.C.R.C. L. 2486 P. 518   | Kobs    | #14097 | 1" Iron Bar             |
|   | 1990 | Cert. Survey Not Recorded | Kobs    | #14097 | 1/2" Capped Iron #14097 |

Description of corner evidence found and/or method applied in restoring or reestablishing corner:

9 I found a 1/2" capped iron #21570 (Robert Higgins) at the C/L of the median of 16 Mile Road running East and West 550' ± West of Schoenherr Road. This iron doesn't match any witnesses. Reset corner using 1969 MCRC witnesses. This point falls 1.14' NE'ly of found iron.

1969 Macomb County Road Commission Records  
SE 47.61 "+" N Edge Eastbound Pavement (m. 47.61')  
SW 47.00' "+" N Edge Eastbound Pavement (m. 47.00')  
NW 51.18' "+" S Edge Westbound Pavement (m. 51.18')

Measure North 2618.40' to K-8 (G.L.O. = 2640.0') (Cert. Survey by Kobs 1990 = 2618.47')  
Measure East 2646.5' to L-9 (G.L.O. = 2626.8')  
Measure South 2689.09' to K-10 (G.L.O. = 2640.0') (Plats = 2688.86')  
Measure West 2707.75' to J-9 (G.L.O. = 2669.04')


Description of monument for corner and accessories established to perpetuate locating the position of the corner:

3 I set a 4" x 36" concrete monument w/2" diameter aluminum cap stamped "Macomb County Monument MI Act 345 #25854."

N 05° E 142.97' - Set Nail and Macomb Co. Remon. Tag in E Face 24" Elm  
N 62° E 193.85' - Set Nail and Macomb Co. Remon. Tag in SE Face T. Pole  
S 06° W 96.08' - Set Nail and Macomb Co. Remon. Tag in NW Face P. Pole  
S 66° W 197.31' - Set Nail and Macomb Co. Remon. Tag in SE Face P. Pole  
N'ly 1.14' capped rebar #21570

The selected location is accepted by me and is generally accepted by professional surveyors as the best available evidence of the position of the original corner.

ACCEPTED BY THE MACOMB COUNTY SURVEY PEER GROUP AS THE OFFICIAL CORNER UNDER MICHIGAN PUBLIC ACT 345 OF 1990 AT A MEETING HELD ON 9-17-96  
  
WILLIAM E. SODERBERG, P.S., CHAIRMAN

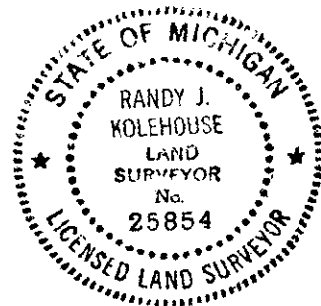

Recorded by Randy J. Kolehouse Date 11/19/96  
Surveyor's Michigan License No. 25854

643