

LAND CORNER RECORDATION CERTIFICATE
Filing Requirement of Act 74, Mich. P.A. 1970

corners in

<u>MACOMB</u> (County)	Located in:	City of Sterling Heights	Corner Code # _____
Public Land Survey	T <u>2N</u>	R <u>12E</u>	<u>K-10</u>
	T _____	R _____	_____
	T _____	R _____	_____
	T _____	R _____	_____
Property Controlling in Section	S _____	T _____	R _____
Miscellaneous	S _____	T _____	R _____
Property in Sec.	S _____	T _____	R _____


SURVEY & REMONUMENTATION

FEB 27 1997

COMMISSION

Register of Deeds Stamp & File Number

Lot No. _____, Recorded Plat _____
 Private Claims _____

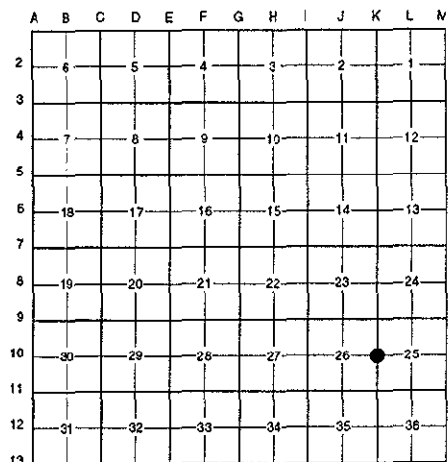

Randy Kolehouse, in a field survey on May 20 19 96, hereby certify that under requirements of P.A. 74 Michigan P.A. of 1970, the corner points mentioned lines 1 and 2 above were in conformance with regulations and rules therefore as required in the present manual of survey instructions of the United States Department of the Interior, Bureau of Land Management or by a decree of a Court of Law and/or that the corner points mentioned in lines 3, 4 and 5 above were in conformance with the rules of the Michigan Board of Land Surveyors or by a Decree of a Court of Law; established, re-established, monumented, re-monumented, recovered, found as pressed below:

NOTE: Not more than 4 corners, all in the same town and range, may be recorded on this certificate.

Description of original monument and accessories and/or subsequent restoration:

10 1817 G.L.O. Notes Wampler N/A Set Post

Anna Lisa Sub. L. 64 P. 3
 Candlewood Village Sub. L. 66 P. 34
 Only information on record.

ACCEPTED BY THE MACOMB COUNTY SURVEY PEER GROUP AS THE OFFICIAL CORNER UNDER MICHIGAN PUBLIC ACT 345 OF 1990 AT A MEETING HELD ON 9-17-96
William E. Soderberg
 WILLIAM E. SODERBERG, P.S., CHAIRMAN

Description of corner evidence found and/or method applied in restoring or reestablishing corner:

10 I found a concrete monument at the NW corner of Candlewood Village Sub. L. 66 P. 34 (NW corner of Lot 46). This monument also checks 250' South of a concrete monument found at the SE corner of Anna Lisa Sub. L. 64 P. 3. No witnesses remain from Wampler's G.L.O. notes.

Measure North 2689.07' to K-9 (G.L.O. = 2640.0') (Plats - 2688.86')
 Measure South 2722.11' to K-11 (G.L.O. = 2640.0')


Description of monument for corner and accessories established to perpetuate locating the position of the corner:

10 I set a 2" diameter aluminum cap stamped "Macomb County Monument MI Act 345 #25854" on an existing concrete monument.

East 9.75' - 4" Dia. Metal Gas Line Marker Post
 S 40° E 46.20' - NW Corner Brick House #13703 Brougham
 S 31° W 45.95' - NE Corner Brick House #13691 Brougham
 S 62° W 2.62' - Set Nail and Macomb Co. Remon. Tag in N Face Util. Pole

The selected location is accepted by me and is generally accepted by professional surveyors as the best available evidence of the position of the original corner.

Witnessed by Randy J. Kolehouse Date 11/13/96
 Surveyor's Michigan License No. 25854

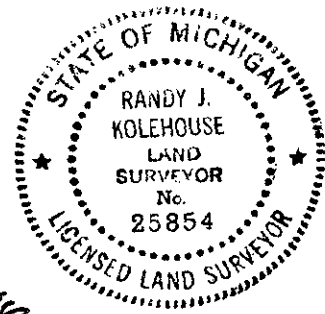

6044