

LAND CORNER RECORDATION CERTIFICATE
 Filing Requirement of Act 74, Mich. P.A. 1970

For corners in

<u>MACOMB</u> (County)	Located in: City of Sterling Heights	Corner Code # K-12
1. Public Land Survey	T <u>2N</u> R <u>12E</u>	<u>K-12</u>
	T _____ R _____	_____
	T _____ R _____	_____
	T _____ R _____	_____
2. Property Controlling in Section	S _____ T _____ R _____	_____
	S _____ T _____ R _____	_____
3. Miscellaneous Property in Sec.	S _____ T _____ R _____	_____
	S _____ T _____ R _____	_____

SURVEYING
 RECOMMENDATION

MAR 25 1999

SECTION

Register of Deeds Stamp & File Number

4. Lot No. _____, Recorded Plat _____
 5. Private Claims _____

I, Bruce Antcliff, in a field survey on July 19 98, do hereby certify that under requirements of P.A. 74 Michigan P.A. of 1970, the corner points mentioned in lines 1 and 2 above were in conformance with regulations and rules therefore as required in the current manual of survey instructions of the United States Department of the Interior, Bureau of Land Management or by a decree of a Court of Law and/or that the corner points mentioned in lines 3, 4 and 5 above were in conformance with the rules of the Michigan Board of Land Surveyors or by a Decree of a Court of Law; established, re-established, monumented, re-monumented, recovered, found as expressed below:

A	B	C	D	E	F	G	H	I	J	K	L	M
2	6	5	4	3	2	1						
3												
4	7	8	9	10	11	12						
5												
6	18	17	16	15	14	13						
7												
8	19	20	21	22	23	24						
9												
10	30	29	28	27	26	25						
11												
12	31	32	33	34	35	36						
13												

NOTE: Not more than 4 corners, all in the same town and range, may be recorded on this certificate.

A. Description of original monument and accessories and/or subsequent restoration:

K-12	1817	G.L.O. Notes	Wampler	N/A	Post
	1965	Kingsley Subdivision	Bridges	#5779	N/A
	1970	MCRC Wit. File #154	Ciemochowski	N/A	Concrete Monument
	1972	L.C.R.C. L. 2317 P. 186	Smith	#16052	Monument
	1989	Cert. Survey L. 04782 P. 177	Smith	#16052	Monument
	1990	L.C.R.C. L. 04799 P. 510	Donnelly	#21563	Iron in Monument Box

B. Description of corner evidence found and/or method applied in restoring or reestablishing corner:

K-12 I found a 1" iron rod in a monument box on the C/L of Schoenherr Road running North and South which checks Kingsley Subdivision and the witnesses listed below.

L.C.R.C. L. 2317 P. 186	L.C.R.C. 04799 P. 510
N 45° E 69.59' PK and MCRC Tag in Power Pole (m. 69.60')	Az 60° 69.55' PK Nail with MCRC Tag S Face U.P. (m. 69.60')
	Az 104° 60.17' PK Nail with RJD Tag S Face U.P. (m. 60.16')
	Az 90° 29.70' Back of Curb (m. 29.83')

Measure North 2578.23' to K-11 (G.L.O. = 2640.0')
 Measure South 2653.18' to K-13 (G.L.O. = 2640.0')

C. Description of monument for corner and accessories established to perpetuate locating the position of the corner:

K-12 I replaced the found 1" iron with a 3/4" x 24" iron rod w/2" diameter aluminum cap stamped "Macomb County Monument MI Act 345 #25826" in an existing monument box.


N 60° E 69.60'	Found PK Nail with MCRC Tag S Face U.P.
S 76° E 60.16'	Found PK Nail with RJD Tag S Face U.P.
N 90° E 29.83'	Back of Curb
N 75° E 40.17'	Found PK Nail with RJD Tag N Face U.P.
N 75° W 73.39'	Set PK Nail S Face 10" Ash
N 40° W 112.63'	Set PK Nail SW Face U.P.

ACCEPTED BY THE MACOMB COUNTY SURVEY PEER GROUP AS THE OFFICIAL CORNER UNDER MICHIGAN PUBLIC ACT 345 OF 1990 AT A MEETING HELD ON 10/27/98

William E. Soeberberg
 WILLIAM E. SOEBERBERG, P.S., CHAIRMAN

The selected location is accepted by me and is generally accepted by professional surveyors as the best available evidence of the position of the original corner.

Signed by Bruce Antcliff Date 11-25-98
 EARTH TECH
 Surveyor's Michigan License No. 25826

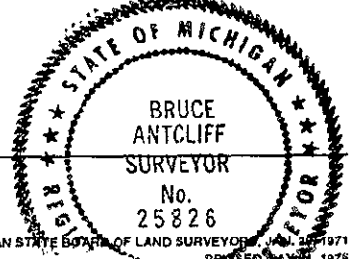

867