


LAND CORNER RECORDATION CERTIFICATE
Filing Requirement of Act 74, Mich. P.A. 1970

corners in
MACOMB
 (County) Located in: City of Sterling Heights Corner Code #
 Public Land Survey T 2N R 12E L-9
 T _____ R _____
 T _____ R _____
 T _____ R _____
 Property Controlling S _____ T _____ R _____
 in Section S _____ T _____ R _____
 Miscellaneous S _____ T _____ R _____
 Property in Sec. S _____ T _____ R _____

SURVEY &
 REMONUMENTATION
 FEB 27 1997
 COMMISSION
 Register of Deeds Stamp & File Number

Lot No. _____, Recorded Plat _____
 Private Claims _____

Randy Kolehouse, in a field survey on May 28 19 96,
 hereby certify that under requirements of P.A. 74 Michigan P.A. of 1970, the corner points mentioned
 lines 1 and 2 above were in conformance with regulations and rules therefore as required in the
 present manual of survey instructions of the United States Department of the interior, Bureau of Land
 Management or by a decree of a Court of Law and/or that the corner points mentioned in lines 3, 4 and 5
 above were in conformance with the rules of the Michigan Board of Land Surveyors or by a Decree of a
 Court of Law; established, re-established, monumented, re-monumented, recovered, found as
 pressed below:

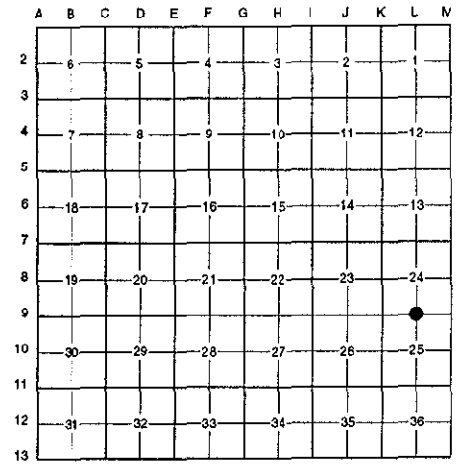

NOTE: Not more than 4 corners, all in the same town and range, may be recorded on this certificate.

Description of original monument and accessories and/or subsequent restoration:

⇒ 1817	G.L.O. Notes	Wampler	N/A	Set Post
	N/A Meadowview Sub. L. 74 P. 36			
1971	Plum Creek Condo L. 2240 P. 530			
1990	Cert. Survey (Not Recorded)	Kobs	#14097	No Corner Shown

Description of corner evidence found and/or method applied in restoring or reestablishing corner:

⇒ I found a 1/2" rebar in the remains of an old fence running East and West that checks the ties to Meadowview Sub. L. 74 P. 36 and also checks tie to Plum Creek Condo L. 2240 P. 530.

ACCEPTED BY THE MACOMB COUNTY SURVEY PEER GROUP AS THE OFFICIAL CORNER UNDER MICHIGAN PUBLIC ACT 345 OF 1990 AT A MEETING HELD ON 9-17-96


 WILLIAM E. SODERBERG, P.S., CHAIRMAN

Measure East 2597.41' to M-9 (G.L.O. = 2640.0')
 Measure West 2646.50' to K-9 (G.L.O. = 2640.0')

Description of monument for corner and accessories established to perpetuate locating the position of the corner:

⇒ I replaced the found 1/2" rebar with a 4" x 36" concrete monument w/2" diameter aluminum cap stamped "Macomb County Monument MI Act 345 #25854."

- N 07° E 16.00' - Found P.K. Nail in W Face 4" Crab Apple (Dead)
- N 40° E 25.22' - Set P.K. Nail w/Macomb County Remon. Tag in W Face 6" Mulberry
- S 33° E 8.71' - Found P.K. Nail in SW Face 12" Ash
- S 33° E 8.63' - Set P.K. Nail w/ Macomb County Remon. Tag in W face 12" Ash
- S 42° W 29.73' - Set P.K. Nail w/ Macomb County Remon. Tag in SE Face 15" Elm
- S 65° W 11.11' - Set P.K. Nail w/ Macomb County Remon. Tag in SE Face 6" Maple

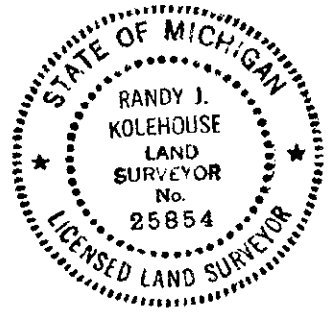

The selected location is accepted by me and is generally accepted by professional surveyors as the best available evidence of the position of the original corner.

Recorded by Randy J. Kolehouse Date 11/19/96
 Surveyor's Michigan License No. 25854