

# SURVEY & REMONUMENTATION

APR 28 1995

C152265

## LAND CORNER RECORDATION CERTIFICATE Filing Requirement of Act 74, Mich. P.A. 1970

94 DEC 14 AM 10:54

COMMISSION

MACOMB COUNTY DEEDS  
MACOMB COUNTY, MI

of corners in \_\_\_\_\_

MACOMB \_\_\_\_\_  
(County)

Located In: Sterling Township Corner Code # \_\_\_\_\_

Public Land Survey T 2N R 12E M-2  
T \_\_\_\_\_ R \_\_\_\_\_  
T \_\_\_\_\_ R \_\_\_\_\_  
T \_\_\_\_\_ R \_\_\_\_\_

Property Controlling S \_\_\_\_\_ T \_\_\_\_\_ R \_\_\_\_\_  
in Section S \_\_\_\_\_ T \_\_\_\_\_ R \_\_\_\_\_  
Miscellaneous S \_\_\_\_\_ T \_\_\_\_\_ R \_\_\_\_\_  
Property in Sec. S \_\_\_\_\_ T \_\_\_\_\_ R \_\_\_\_\_

LIBER 8527 PAGE 842

Register of Deeds Stamp & File Number

Lot No. \_\_\_\_\_, Recorded Plat \_\_\_\_\_  
Private Claims \_\_\_\_\_

	A	B	C	D	E	F	G	H	I	J	K	L	M
2	6	5	4	3	2	1							
3													
4	7	8	9	10	11	12							
5													
6	18	17	16	15	14	13							
7													
8	19	20	21	22	23	24							
9													
10	30	29	28	27	26	25							
11													
12	31	32	33	34	35	36							
13													

Randy Kolehouse, in a field survey on July 15, 1994,

hereby certify that under requirements of P.A. 74, Michigan P.A. of 1970, the corner points mentioned in lines 1 and 2 above were in conformance with regulations and rules therefore as required in the current manual of survey instructions of the United States Department of the Interior, Bureau of Land Management or by a decree of a Court of Law and/or that the corner points mentioned in lines 3, 4 and 5 above were in conformance with the rules of the Michigan Board of Land Surveyors or by a Decree of a Court of Law; established, re-established, monumented, re-monumented, recovered, found as pressed below:

**NOTE: Not more than 4 corners, all in the same town and range, may be recorded on this certificate.**

Description of original monument and accessories and/or subsequent restoration:

#	Year	G.L.O.	Notes	Wampler	N/A	Post
-2	1817	G.L.O.	Notes	Wampler	N/A	Post
	1934	MCRC	Files	N/A	N/A	
	1974	MDOT	Field Notes	Lindgren	#14098	1" Gas Pipe
	1974	L.C.R.C.	L. 2500 P. 796	Julls/Lindgren	#02934	1" Iron Pipe
	1977	L.C.R.C.	L. 2886 P. 442	Patterson	#17631	1" Iron Pipe
	1980	D.E. Co.	Field Notes	N/A	N/A	1" Iron Pipe
	1988	MDOT	Field Notes	Schultz	#31610	1" Iron
	1989	MCRC	Files	DeWinnter	N/A	1" Iron Pin
	1990	L.C.R.C.	L. 4888 P. 977	Gorman	#17622	FDI 1" Iron Pipe Set 5'8" Copper Clad Iron in Box
	1992	MCRC	Hayes Rd. Prints	N/A	N/A	N/A

Description of corner evidence found and/or method applied in restoring or reestablishing corner:

2 Found 1/2" rebar in monument box in center line of Hayes and S. Line of Shore Line Drive.

1988 MDOT Field Notes	L.C.R.C. L. 4888 P. 977	MCRC Hayes Road Repaving Project
MDOT Nail & Tag P. Pole N 25° W 90.03'	MDOT Tag Guy Pole E 40.19'	Star Drill in Top Curb NW'y 168.91'
S. Bolt Lt. Pole Base N 50° E 95.08'	MDOT Tag P. Pole S 30° W 85.46'	Star Drill in Top Curb SW'y 177.81'
Center Line Top Fire Hyd. S 60° W 61.45'	Center Line Top Fire Hyd. S 55° W 61.48'	Star Drill in Walk E 57.44'
1989 MCRC Field Notes	MShD Nail & Tag P. Pole N 50° W 89.98'	Star Drill in Walk NE'y 139.31'
PK 15" Maple NE 111.92'		
PK Util. Pole SW 85.49'		
PK Util. Pole NW 90.03'		

ACCEPTED BY THE MACOMB COUNTY SURVEY PEER GROUP AS THE OFFICIAL CORNER UNDER MICHIGAN PUBLIC ACT 345 OF 1990 AT A MEETING HELD ON 9-30-94  
*William E. Soderberg*  
WILLIAM E. SODERBERG, P.S., CHAIRMAN


Measure N 2703.24 to M-1 (MDOT 2702.78) (G.L.O. 2640)  
Measure S. 2708.28 to M-3 (G.L.O. 2640)  
This corner location is common with A-2 T2N R13E.

Description of monument for corner and accessories established to perpetuate locating the position of the corner:

2 I replaced the found 1/2" Rebar with a 3/4" x 24" Iron Rod w/2" diameter aluminum cap stamped "Macomb County Monument MI Act 345 #25854" in an existing Monument Box.

- \*+ S. Bolt Lt. Pole Base N 57° E 94.78'
- Nail with "MDOT" Tag N. Face Signal Pole S 84° E 39.78'
- Nail with "MDOT" Tag W. Face Util. Pole S 36° W 85.51'
- Nail with "MDOT" Tag SW Face Util. Pole N 22° W 90.12'

The selected location is accepted by me and is generally accepted by professional surveyors as the best available evidence of the position of the original corner.

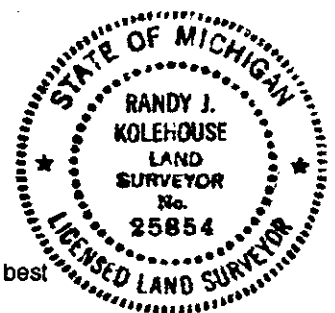

Signed by *Randy J. Kolehouse*  
Surveyor's Michigan License No. 25854

Date 10/14/94