

SURVEY & REMONUMENTATION

APR 28 1995

C152267

LAND CORNER RECORDATION CERTIFICATE

94 DEC 14 AM 10:54

COMMISSION

Filing Requirement of Act 74, Mich. P.A. 1970

MACOMB COUNTY
REGISTER OF DEEDS
LANSING, MI

LIBER 6527 PAGE 844

Register of Deeds Stamp & File Number

or corners in _____

MACOMB Located In: Sterling Corner Code #
(County) Township

Public Land Survey	T <u>2N</u> R <u>12E</u>	<u>M-4</u>
	T _____ R _____	_____
	T _____ R _____	_____
	T _____ R _____	_____
Property Controlling	S _____ T _____ R _____	_____
in Section	S _____ T _____ R _____	_____
Miscellaneous	S _____ T _____ R _____	_____
Property in Sec.	S _____ T _____ R _____	_____

Lot No. _____, Recorded Plat _____
Private Claims _____

	A	B	C	D	E	F	G	H	I	J	K	L	M
2	6	5	4	3	2	1							
3													
4	7	8	9	10	11	12							
5													
6	18	17	16	15	14	13							
7													
8	19	20	21	22	23	24							
9													
10	30	29	28	27	26	25							
11													
12	31	32	33	34	35	36							
13													

Randy Kolehouse in a field survey on July 15, 19 94,
I hereby certify that under requirements of P.A. 74, Michigan P.A. of 1970, the corner points mentioned
in lines 1 and 2 above were in conformance with regulations and rules therefore as required in the
current manual of survey instructions of the United States Department of the Interior, Bureau of Land
Management or by a decree of a Court of Law and/or that the corner points mentioned in lines 3, 4 and 5
above were in conformance with the rules of the Michigan Board of Land Surveyors or by a Decree of a
Court of Law; established, re-established, monumented, re-monumented, recovered, found as
expressed below:

NOTE: Not more than 4 corners, all in the same town and range, may be recorded on this certificate.

Description of original monument and accessories and/or subsequent restoration:

A-4	1817	G.L.O.	Notes	Wampler	NA	Post
	1934	MCRC	Files	N/A	N/A	1" Solid Iron
	1972	Cert. Survey	L. 2314 P. 234	Avey	#15396	3/4" Pipe
	1973	L.C.R.C.	L. 2464 P. 470	South	#20623	1" Pipe
	1977	Cert. Survey	L. 2772 P. 460-465	Smith	#16052	1" Pipe
	1978	Cert. Survey	L. 2936 P. 775	Smith	#16052	1" Pipe
	1979	L.C.R.C.	L. 3184 P. 577	Fenn	#23505	1" Pipe
	?	MCRC	Files	N/A	N/A	Pipe

Description of corner evidence found and/or method applied in restoring or reestablishing corner:

A-4 Found 1" pipe in center line of Hayes Road.

L.C.R.C. L. 2464 P. 470 SE Cor. Brick House #42109 NW 150.69' NE Cor. House #42071 WSW 90.69' SW Cor. House #42100 NE 99.39'	Cert. Survey L. 2314 P. 234 16D Cone Nail NE Face Util. Pole NW 108.85'
L.C.R.C. L. 3184 P. 577 Nail in Util. Pole NW 108.95'	L.C.R.C. L. 4718 P. 611 SW Cor. House #42100 ENE 99.26' SE Cor. House #42109 NW 150.62' NW Cor. Building (Vinnie's) ENE 138.40' SE Cor. House #42087 WNW 123.04'


Measure N. 2706.06 to M-3 (G.L.O. 2640)
 Measure S. 2698.47 to M-5 (G.L.O. 2640)
 This corner location is common with A-4 T2N R13E.

Description of monument for corner and accessories established to perpetuate locating the position of the corner:

A-4 I replaced the found 1" Iron Pipe with a 3/4" x 24" Iron Rod w/2" diameter aluminum cap stamped "Macomb County Monument MI Act 345 #25854," also set Monument Box.

SW Cor. House #42100 N 62° E 99.27'
 NW Cor. Building "Vinnie's" S 72° E 138.47'
 SE Cor. House #42087 N 85° W 122.96'
 SE Cor. House #42109 N 43° W 150.61'
 Conc. Nail NE Face P. Pole N 19° W 108.88'

ACCEPTED BY THE MACOMB COUNTY SURVEY PEER GROUP AS THE OFFICIAL CORNER UNDER MICHIGAN PUBLIC ACT 345 OF 1980 AT A MEETING HELD ON 8-16-94
William E. Soderberg
 WILLIAM E. SODERBERG, P.S., CHAIRMAN

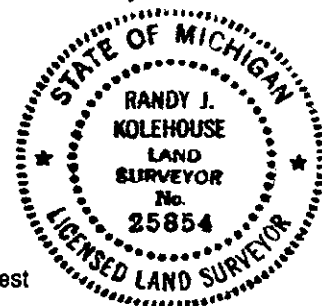

The selected location is accepted by me and is generally accepted by professional surveyors as the best available evidence of the position of the original corner.

Signed by Randy J. Kolehouse
 Surveyor's Michigan License No. 25854

Date 10/14/94