

**SURVEY &
REMONUMENTATION**

APR 28 1995

**LAND CORNER RECORDATION CERTIFICATE
Filing Requirement of Act 74, Mich. P.A. 1970**

C152269

94 DEC 11 AM 10:54

or corners in
MACOMB

COMMISSION

Located In: **Sterling Township** Corner Code **#**

REG. DEEDS
MACOMB COUNTY, MI

Public Land Survey	T <u>2N</u> R <u>12E</u>	<u>M-6</u>
	T _____ R _____	_____
	T _____ R _____	_____
	T _____ R _____	_____
Property Controlling in Section	S _____ T _____ R _____	_____
Miscellaneous	S _____ T _____ R _____	_____
Property in Sec.	S _____ T _____ R _____	_____

LIBER **6527** PAGE **846**

Register of Deeds Stamp & File Number

Lot No. _____, Recorded Plat _____
Private Claims _____

A	B	C	D	E	F	G	H	I	J	K	L	M
2	6	5	4	3	2	1						
3												
4	7	8	9	10	11	12						
5												
6	18	17	16	15	14	13						
7												
8	19	20	21	22	23	24						
9												
10	30	29	28	27	26	25						
11												
12	31	32	33	34	35	36						
13												

Randy Kolehouse in a field survey on July 15, 1994,
I hereby certify that under requirements of P.A. 74, Michigan P.A. of 1970, the corner points mentioned in lines 1 and 2 above were in conformance with regulations and rules therefore as required in the current manual of survey instructions of the United States Department of the Interior, Bureau of Land Management or by a decree of a Court of Law and/or that the corner points mentioned in lines 3, 4 and 5 above were in conformance with the rules of the Michigan Board of Land Surveyors or by a Decree of a Court of Law; established, re-established, monumented, re-monumented, recovered, found as expressed below:

NOTE: Not more than 4 corners, all in the same town and range, may be recorded on this certificate.

Description of original monument and accessories and/or subsequent restoration:	Notes	Wampler	NA	Post
A-6 1817 G.L.O.				
1972 L.C.R.C.	L. 2302 P. 145, 146	Brabant	#17611	1/2" Bar
1972 Survey	L. 2302 P. 144	Brabant	#17611	
1977 Cert. Survey	L. 2761 P. 470	Smith	#16052	Iron
1977 L.C.R.C.	L. 2918 P. 56	Patterson	#17631	1/2" Iron
1977 Cert. Survey	L. 2865 P. 247	Avey	#15396	1/2" Bar
	L. 2886 P. 965			
1978 L.C.R.C.	L. 2902 P. 559	Soderberg	#17635	1" Iron Pipe
1978 L.C.R.C.	L. 3059 P. 199	Soderberg	#17635	1/2" Re-Rod
1989 L.C.R.C.	L. 4799 P. 506	Donnelly	#21563	1/2" Rod

Description of corner evidence found and/or method applied in restoring or reestablishing corner:

A-6 Found 1/2" rebar in center line of Hayes Rd. and Stadler Road.

L.C.R.C. L. 2918 P. 56 Nail and Washer Util. Pole ESE 59.18' Nail and Washer Util. Pole NW 57.62'	L.C.R.C.'s L. 2865 P. 247, 249 and L. 2886 P. 965 16D Nail and Washer NW Face Util. Pole NW 57.62' 16 D. Nail and Washer S Face Util. Pole E 59.13'	L.C.R.C. L. 3059 P. 199 PK NE Face DE Pole NW 57.46' Nail S Face DE Pole E 59.24'
---	---	---

L.C.R.C. L. 2902 P. 559 Nail and Washer N Face Util. Pole NW 57.64' Nail and Washer S Face Util. Pole E 59.23'	L.C.R.C. L. 4799 P. 506 PK with Tag S Face Util. Pole ESE 59.20' Center Line Top Nut Hyd. NW 73.68'
--	---


ACCEPTED BY THE MACOMB COUNTY SURVEY PEER GROUP AS THE OFFICIAL CORNER UNDER MICHIGAN PUBLIC ACT 345 OF 1990 AT A MEETING HELD ON 8-16-94.
William E. Soderberg
WILLIAM E. SODERBERG, P.S., CHAIRMAN

Measure N. 2695.56 to M-5 (G.L.O. 2640)
Measure S. 2672.50 to M-7 (Survey L. 2302 P. 144 = 2673.1) (G.L.O. 2640)
This corner location is common with A-6 T2N R13E.

Description of monument for corner and accessories established to perpetuate locating the position of the corner:

A-6 I replaced the found 1/2" Rebar with a 3/4" x 24" Iron Rod w/2" diameter aluminum cap stamped "Macomb County Monument MI Act 345 #25854," also set Monument Box.

PK with Tag #21563 S Face Util. Pole S 80° E 59.22'
PK & Macomb Co. Remon. Tag in NW Face Util. Pole S 24° W 134.03'
PK NE Face Util. Pole N 47° W 58.73'
Center Line Top Nut Fire Hyd. N 27° W 73.81'

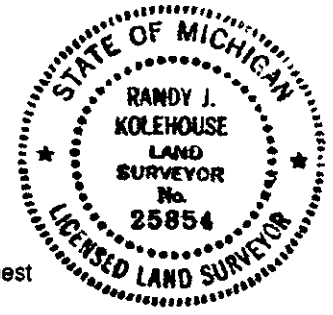

The selected location is accepted by me and is generally accepted by professional surveyors as the best available evidence of the position of the original corner.

Signed by Randy J. Kolehouse Date 10/14/94
Surveyor's Michigan License No. 25854