

C152271

LAND CORNER RECORDATION CERTIFICATE
Filing Requirement of Act 74, Mich. P.A. 1970

For corners in
MACOMB
(County)

Located In: Sterling Township Corner Code #

94 DEC 14 AM 10:54

CALC. REG. 12000 HIGH DEEDS CITY, MI

- 1. Public Land Survey T 2N R 12E M-8
2. Property Controlling in Section S T R
3. Miscellaneous Property in Sec. S T R

LIBER 6527 PAGE 848

Register of Deeds Stamp & File Number

- 4. Lot No. , Recorded Plat
5. Private Claims

Grid table with columns A-M and rows 2-13. Cell 8,24 contains a black dot.

I, Randy Kolehouse, in a field survey on June 30, 1994, do hereby certify that under requirements of P.A. 74, Michigan P.A. of 1970, the corner points mentioned in lines 1 and 2 above were in conformance with regulations and rules therefore as required in the current manual of survey instructions of the United States Department of the Interior, Bureau of Land Management or by a decree of a Court of Law and/or that the corner points mentioned in lines 3, 4 and 5 above were in conformance with the rules of the Michigan Board of Land Surveyors or by a Decree of a Court of Law; established, re-established, monumented, re-monumented, recovered, found as expressed below:

NOTE: Not more than 4 corners, all in the same town and range, may be recorded on this certificate.

A. Description of original monument and accessories and/or subsequent restoration:

Table with columns: M-8, 1817, G.L.O., Notes, Wampler, N/A, Post. Rows include MCRC, L.C.R.C., and Patterson.

SURVEY & MONUMENTATION

APR 20 2000

SECTION

B. Description of corner evidence found and/or method applied in restoring or reestablishing corner:

M-8 Found PK Nail in Center Line of Hayes Road over a 1" Iron pipe which is 6" below asphalt road surface in old concrete roadway.

MCRC Field Notes (1984)
PK in NE Face Util. Pole ESE 52.32'
Center Line Hyd. SE 66.05'
PK in SE Face Util. Pole SW 80.10'

L.C.R.C. L. 5509 P. 445
PK in 18" Ash E 100.87'
PK in Util. Pole S 45° W 80.14'
PK in Util. Pole N 30° W 66.88'

Measure N. 2701.00 to A-7 (River Park Estates = 2700.3) (G.L.O. 2640)
Measure S 2641.87 to M-9 (G.L.O. 2640)
This corner location is common with A-8 T2N R13E.


ACCEPTED BY THE MACOMB COUNTY SURVEY PEER GROUP AS THE OFFICIAL CORNER UNDER MICHIGAN PUBLIC ACT 345 OF 1890 AT A MEETING HELD ON 9-20-94

Signature of William E. Soderberg, P.S., Chairman

C. Description of monument for corner and accessories established to perpetuate locating the position of the corner:

M-8 I replaced the found PK Nail with a 3/4" x 24" Iron Rod w/2" diameter aluminum cap stamped "Macomb County Monument MI Act 345 #25854." set Monument Box.

PK with Tag "GW #78155" S Face 24" Ash S 82° E 100.76'
PK NE Face Util. Pole S 38° E 52.27'
Center Line Top Nut Fire Hyd. S 37° E 65.90'
PK E. Face Util. Pole S 30° W 80.04'
Nail with Tag "GW #78154" SW Face Util. Pole N 28° W 61.83'

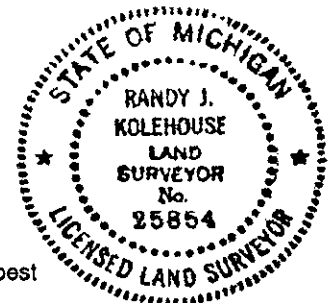

The selected location is accepted by me and is generally accepted by professional surveyors as the best available evidence of the position of the original corner.

Signed by Randy J. Kolehouse, 25854
Surveyor's Michigan License No.

Date 10/19/94