

SURVEY & REMONUMENTATION

LAND CORNER RECORDATION CERTIFICATE
Filing Requirement of Act 74, Mich. P.A. 1970

FEB 27 1997

COMMISSION

or corners in

MACOMB
 (County)

Located in: City of Sterling Heights Corner Code # _____

Public Land Survey T 2N R 12E M-10
 T _____ R _____
 T _____ R _____
 T _____ R _____
 Property Controlling S _____ T _____ R _____
 in Section S _____ T _____ R _____
 Miscellaneous S _____ T _____ R _____
 Property in Sec. S _____ T _____ R _____

Register of Deeds Stamp & File Number

Lot No. _____, Recorded Plat _____
 Private Claims _____

Randy Kolehouse, in a field survey on April 24 19 96, hereby certify that under requirements of P.A. 74 Michigan P.A. of 1970, the corner points mentioned in lines 1 and 2 above were in conformance with regulations and rules therefore as required in the current manual of survey instructions of the United States Department of the interior, Bureau of Land Management or by a decree of a Court of Law and/or that the corner points mentioned in lines 3, 4 and 5 above were in conformance with the rules of the Michigan Board of Land Surveyors or by a Decree of a Court of Law; established, re-established, monumented, re-monumented, recovered, found as pressed below:

	A	B	C	D	E	F	G	H	I	J	K	L	M
2	6	5	4	3	2								
3													
4	7	6	5	4	3	2	1						
5													
6	18	17	16	15	14	13	12	11	10	9	8	7	6
7													
8	19	20	21	22	23	24	25	26	27	28	29	30	31
9													
10	30	29	28	27	26	25	24	23	22	21	20	19	18
11													
12	31	32	33	34	35	36							
13													

NOTE: Not more than 4 corners, all in the same town and range, may be recorded on this certificate.

Description of original monument and accessories and/or subsequent restoration:


-10 Records indicate this corner is common with A-10, T2N, R13E.

1817	G.L.O. Notes	Preston	N/A	Small Beech
1983	L.C.R.C. L. 3475 P. 114	Kattouah	#14095	Set 1/2" Capped Iron

Description of corner evidence found and/or method applied in restoring or reestablishing corner:

10 I found a 1/2" rebar w/cap No. 14095 15' ± South of C/L of a drain which checks with the following witnesses. This iron is on a straight line ± between M-9 and M-11. Also found iron pipe (no information on record) 0.19' NW'ly. No witnesses given in Preston's G.L.O. notes.

L.C.R.C. L. 3475 P. 114
 P.K. Nail N. Face, 18" Oak West 30.74 Ft. (m. 30.71')
 South 31.17 Ft. P.K. Nail N. Face, Twin 12" Cherry (m. 31.17')
 P.K. Nail N. Face, T.R1, 12" Basswood East 3.25 Ft. (m. 3.49')
 East 33.11 Ft., Nail S. Face-Quad 15" Basswood (m. 33.04')

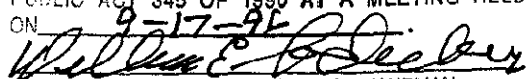ACCEPTED BY THE MACOMB COUNTY SURVEY PEER GROUP AS THE OFFICIAL CORNER UNDER MICHIGAN PUBLIC ACT 345 OF 1990 AT A MEETING HELD ON 9-17-96

 WILLIAM E. SODERBERG, P.S., CHAIRMAN

Measure North 2776.14' to M-9 (G.L.O. = 2640.0')
 Measure South 2727.63' to M-11 (G.L.O. = 2640.0')


Description of monument for corner and accessories established to perpetuate locating the position of the corner:

10 I replaced the found capped iron with a 4" x 36" concrete monument w/2" diameter aluminum cap stamped "Macomb County Monument MI Act 345 #25854."

S 84° E 33.04' - Set Nail and Macomb Co. Remon. Tag in S Face 20" Quad. Tree
 S 79° E 3.49' - Set Nail and Macomb Co. Remon. Tag in N Face 18" Triple Tree
 S 06° W 31.17' - Set Nail and Macomb Co. Remon. Tag in W Face 18" Cherry
 N 86° W 30.71' - Set Nail and Macomb Co. Remon. Tag in N Face 20" Oak

The selected location is accepted by me and is generally accepted by professional surveyors as the best available evidence of the position of the original corner.

Recorded by Randy J. Kolehouse Date 11/19/96
 Surveyor's Michigan License No. 25854

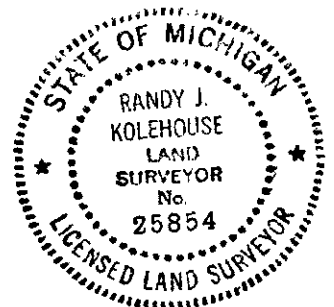

1048