


SURVEY &
REMONUMENTATION

NOV 06 1998

SECTION

Clinton Township T2N, R13E

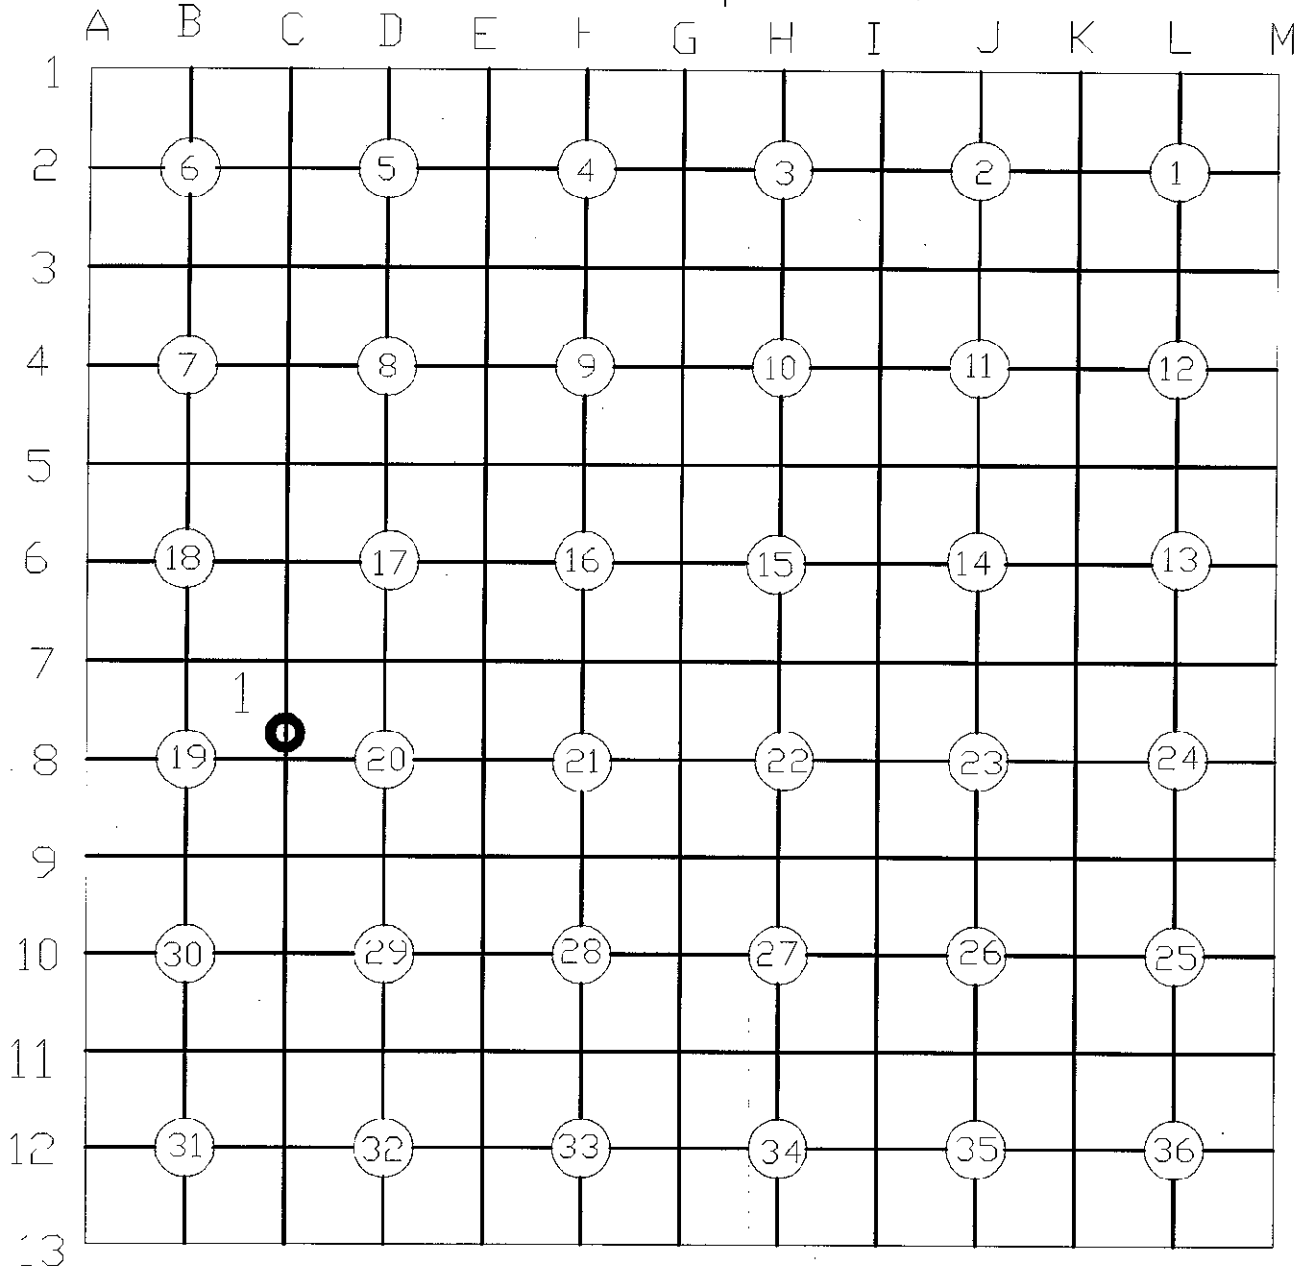

1, = PPC NORTH OF C-8 RECORDED L6527 P 798 #804