

# SURVEY & REMONUMENTATION

APR 28 1995

## LAND CORNER RECORDATION CERTIFICATE Filing Requirement of Act 74, Mich. P.A. 1970

C152206

corners in **COMMISSION**

<u>MACOMB</u> <small>(County)</small>	Located In: <u>Clinton</u> Township	Corner Code <u>≠</u>	
Public Land Survey	T <u>2N</u> R <u>13E</u>	<u>A-3</u>	
	T _____ R _____	_____	_____
	T _____ R _____	_____	_____
	T _____ R _____	_____	_____
Property Controlling	S _____ T _____ R _____	_____	_____
in Section	S _____ T _____ R _____	_____	_____
Miscellaneous	S _____ T _____ R _____	_____	_____
Property in Sec.	S _____ T _____ R _____	_____	_____

94 DEC 14 AM 10:51

DATE REC'D  
MACOMB COUNTY, MI

LAUGH  
REEDS  
COUNTY, MI


LIBER 6527 PAGE 783

Register of Deeds Stamp & File Number

Lot No. \_\_\_\_\_, Recorded Plat \_\_\_\_\_  
Private Claims \_\_\_\_\_

Randy Kolehouse in a field survey on July 17, 1994,  
hereby certify that under requirements of P.A. 74, Michigan P.A. of 1970, the corner points mentioned  
lines 1 and 2 above were in conformance with regulations and rules therefore as required in the  
current manual of survey instructions of the United States Department of the Interior, Bureau of Land  
Management or by a decree of a Court of Law and/or that the corner points mentioned in lines 3, 4 and 5  
above were in conformance with the rules of the Michigan Board of Land Surveyors or by a Decree of a  
Court of Law; established, re-established, monumented, re-monumented, recovered, found as  
expressed below:

**NOTE: Not more than 4 corners, all in the same town and range, may be recorded on this certificate.**

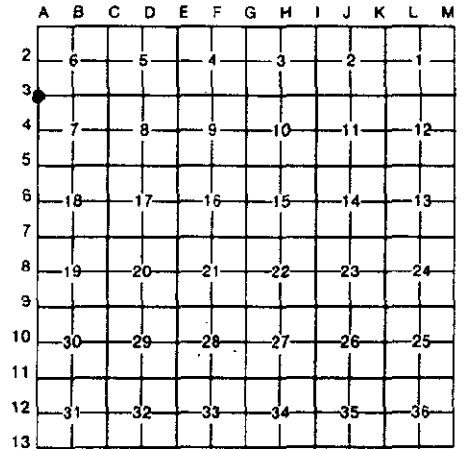

3	Description of original monument and accessories and/or subsequent restoration:	Notes	Wampler	NA	Post
	1817	G.L.O.	Wampler	NA	Post
	1972	Survey	Avey	#15396	1" Pipe
	1972	L.C.R.C.	Kobs	#14097	3/4" Pipe
	1973	Survey	Avendt	#16034	1" Pipe
	1973	L.C.R.C.	South	#20623	1" Pipe
	1976	Survey	Avendt	#16034	1" Pipe in Box
	1979	L.C.R.C.	Fenn	#23505	1-1/2" Pipe in Box
	1979	Survey	Soderberg	#17635	N/A
	1986	L.C.R.C.	Soderberg	#17635	Rebar with Cap
	1989	L.C.R.C.	Money	#30092	2" Iron in Box
	1992	M.C.R.C.	N/A	N/A	N/A

Description of corner evidence found and/or method applied in restoring or reestablishing corner:

3 Found 1/2" rebar in monument box center line intersection of Hayes Rd. & 19-Mile Rd.

L.C.R.C. L. 4718 P. 611  
Top of Hyd. NE 79.11'

MCRC Hayes Rd. Repaving Prints  
Star Drill in Walk NE 137.33'  
Star Drill in Walk SW 138.80'

- Measure N 2708.28 to A-2 (G.L.O. 2640)
- Measure S 2706.06 to A-4 (G.L.O. 2640)
- Measure E 2668.33 to B-3 (Survey L. 2393 P. 593 = 2668.15) (G.L.O. 2640)
- Measure W 2703.09 W to L-3 T2N R12E (G.L.O. 2640)

This corner location is common with the M-3 T2N R12E.


ACCEPTED BY THE MACOMB COUNTY SURVEY PEER  
GROUP AS THE OFFICIAL CORNER UNDER MICHIGAN  
PUBLIC ACT 345 OF 1990 AT A MEETING HELD  
ON 8-30-94  
William E. Soderberg  
WILLIAM E. SODERBERG, P.S., CHAIRMAN

Description of monument for corner and accessories established to perpetuate locating the position of the corner:

3 I replaced the found 1/2" Rebar with a 3/4" x 24" Iron Rod w/2" diameter aluminum cap stamped "Macomb County  
Monument MI Act 345 #25854" in an existing Monument Box.

- Center Line Top Nut Fire Hyd. N 70° E 79.08'
- Set PK & Remon. Washer SW Face Util. Pole S 46° E 81.13'
- PK SE Face Util. Pole S 47° W 69.38'
- Set PK with MCRC Tag NE Face Util. Pole N 37° W 87.21'

The selected location is accepted by me and is generally accepted by professional surveyors as the best  
available evidence of the position of the original corner.

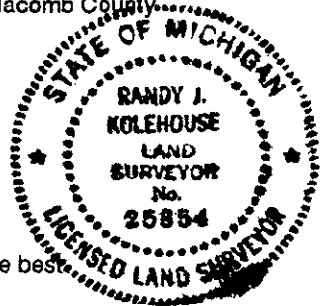

Recorded by Randy J. Kolehouse Date 10/14/94  
Surveyor's Michigan License No. 25854