SURVEY &
REMONUMENTATION

APR 2 8 1995

COMMISSION

C152208

LAND CORNER RECORDATION CERTIFICATE
Filing Requirement of Act 74, Mich. P.A. 1970

LIBER 6527 PAGE 785

94 DEC 14 AM 10: 51

REGISTER OF DEEDS
MACOMB COUNTY, MI

Register of Deeds Stamp & File Number

r corners in MACOMB (County) Located In: Clinton Township Corner Code #

Public Land Survey		T 2N	R 13E	A-5
		T	R	
		T	R	
		T	R	
Property Controlling	S	T	R	
in Section	S	T	R	
Miscellaneous	S	T	R	
Property in Sec.	S	T	R	

Lot No. _____ , Recorded Plat _____
Private Claims _____

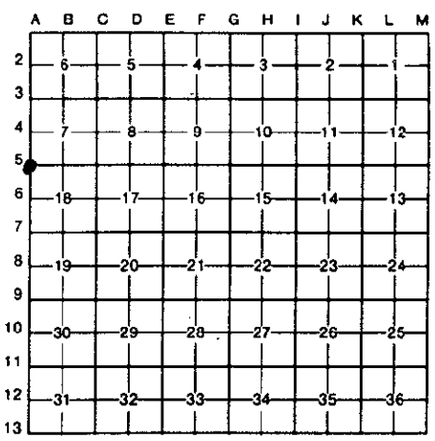

Randy Kolehouse, in a field survey on July 15, 19 94, hereby certify that under requirements of P.A. 74, Michigan P.A. of 1970, the corner points mentioned lines 1 and 2 above were in conformance with regulations and rules therefore as required in the rrent manual of survey instructions of the United States Department of the Interior, Bureau of Land nagement or by a decree of a Court of Law and/or that the corner points mentioned in lines 3, 4 and 5 ove were in conformance with the rules of the Michigan Board of Land Surveyors or by a Decree of a urt of Law; established, re-established, monumented, re-monumented, recovered, found as pressed below:

OTE: Not more than 4 corners, all in the same town and range, may be recorded on this certificate.

Description of original monument and accessories and/or subsequent restoration:

5	1817	G.L.O.	Notes	Wampler	NA	Post
	1973	L.C.R.C.	L. 2464 P. 462	South	#20623	1" Pipe
	1977	Cert. Survey	L. 2761 P. 470	Smith	#16052	1" Pipe
	1977	Cert. Survey	L. 2773 P. 187, 188	Levine	#11076	Iron Pipe
	1977	L.C.R.C.	L. 2918 P. 56	Patterson	#17631	1/2" Iron
	1977	Cert. Survey	L. 2772 P.460-462	Smith	#16052	1" Pipe
	1978	L.C.R.C.	L. 2902 P. 559	Soderberg	#17635	1" Pipe
	1978	Cert. Survey	L. 2936 P. 775	Smith	#16052	1" Pipe
	1978	L.C.R.C.	L. 3059 P. 199	Soderberg	#17635	1" Pipe

Description of corner evidence found and/or method applied in restoring or reestablishing corner:

5 Found 1-1/2" pipe in box in center line of Hayes and 18 Mile Road.

L.C.R.C. L. 2902 P. 559
Top Center Line of Hyd. SSW 155.80'

L.C.R.C. L. 3059 P. 199
Center Line Sanitary M.H. NE 62.95'

L.C.R.C. L. 2918 P. 56
PK In Utl. Pole NE'ly 86.16'
Center Line Top Nut Fire Hyd. 155.76'

Measure N. 2698.47 to A-4 (Survey L. 2772 P. 460 = 2698.85) (G.L.O. = 2640)
Measure S. 2695.56 to A-6 (G.L.O. = 2640)
Measure E. 2613.78 to B-5 T2N R13E (G.L.O. = 2583.9)
Measure 2634.37 W to L-5 (Washington Woods Sub = 2685.06) (G.L.O. 2640)
This corner location is common with M-5 T2N R12E.

ACCEPTED BY THE MACOMB COUNTY SURVEY PEER GROUP AS THE OFFICIAL CORNER UNDER MICHIGAN PUBLIC ACT 345 OF 1990 AT A MEETING HELD ON 8-30-94
William E. Soderberg
WILLIAM E. SODERBERG, P.S., CHAIRMAN

Description of monument for corner and accessories established to perpetuate locating the position of the corner:

5 I replaced the found 1-1/2" Pipe with a 3/4" x 24" Iron Rod w/2" diameter aluminum cap stamped "Macomb County Monument MI Act 345 #25854," also set Monument Box.

PK SE Face Utl. Pole N 48° E 86.09'
PK & Macomb Co. Remon. Tag in NE Face Utl. Pole S 33° E 66.35'
Center Line Top Nut Fire Hyd. S 20° W 155.70'
PK S Face Utl. Pole N 55° W 51.60'

STATE OF MICHIGAN
RANDY J. KOLEHOUSE
LAND SURVEYOR
No. 25854
LICENSED LAND SURVEYOR

The selected location is accepted by me and is generally accepted by professional surveyors as the best available evidence of the position of the original corner.

ned by Randy J. Kolehouse Date 10/14/94
veyor's Michigan License No. 25854

FORM APPROVED BY MICHIGAN STATE BOARD OF LAND SURVEYORS, JAN. 26, 1971
REVISED MAY 14, 1975
REVISED JAN., 1983