SURVEY &
REMONUMENTATION

APR 2 8 1995

COMMISSION

C152210

LAND CORNER RECORDATION CERTIFICATE
Filing Requirement of Act 74, Mich. P.A. 1970

LIBER 6527 PAGE 787

94 DEC 14 AM 10: 51

CAR[illegible] [illegible]AUGH
REG[illegible] [illegible]EEDS
MA[illegible] [illegible]TY MI

Register of Deeds Stamp & File Number

r corners in MACOMB (County) Located In: Clinton Township Corner Code ##

Public Land Survey		T 2N	R 13E	A-7
		T ___	R ___	
		T ___	R ___	
		T ___	R ___	
Property Controlling	S ___	T ___	R ___	
in Section	S ___	T ___	R ___	
Miscellaneous	S ___	T ___	R ___	
Property in Sec.	S ___	T ___	R ___	

Lot No. _____, Recorded Plat _____
Private Claims _____

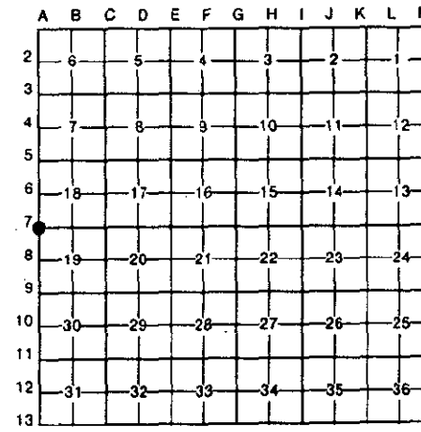

Randy Kolehouse, in a field survey on July 14, 19 94, hereby certify that under requirements of P.A. 74, Michigan P.A. of 1970, the corner points mentioned lines 1 and 2 above were in conformance with regulations and rules therefore as required in the rrent manual of survey instructions of the United States Department of the Interior, Bureau of Land nagement or by a decree of a Court of Law and/or that the corner points mentioned in lines 3, 4 and 5 ove were in conformance with the rules of the Michigan Board of Land Surveyors or by a Decree of a urt of Law; established, re-established, monumented, re-monumented, recovered, found as ressed below:

TE: Not more than 4 corners, all in the same town and range, may be recorded on this certificate.

Description of original monument and accessories and/or subsequent restoration:

7	1817	G.L.O.	Notes	Wampler	NA	Post
	1972	L.C.R.C.	L. 2302 P. 145, 146	Brabant	#17611	1/2" Iron Bar
	1972	Cert. Survey	L. 2351 P. 320	Avey	#15396	5'8" Sq. Bar
	1976	L.C.R.C.	L. 2902 P. 558	Soderberg	#17635	1" Sq. Bar
	1977	Cert. Survey and	L. 2865 P. 247, 249 L. 2886 P. 965	Avey	#15396	5/8" Sq. Bar
	1978	L.C.R.C.	L. 3106 P. 714	Soderberg	#17635	5/8" Sq. Bar
	1984	M.C.R.C.	Field Notes	Soderberg	#17635	1" Steel Rod
	1991	L.C.R.C.	L. 5509 P. 445	Patterson	#17631	3/4" Iron

Description of corner evidence found and/or method applied in restoring or reestablishing corner:

7 Found 5/8" square rod at center line Hays and 17 Mile Road.

L.C.R.C. L. 2302 P. 145
SW Cor. of E. Headwell NE 35.95'
Cert. Survey L. 2351 P. 320
PK with Washer ENE Face Utl. Pole NW 117.39'
Center Line Hole in Gatewell NE 76.21'
Center Line Top Nut Fire Hyd. NE 88.60'

L.C.R.C. L. 3106 P. 714
PK with Washer in Utl. Pole NW 117.39'
Center Line Gate Valve NE 76.21'
Center Line Fire Hyd. NE 88.60'
MCRC Field Notes
PK in W Face UP SW 180.36'
PK in SW Face UP NW 117.20

L.C.R.C. L. 2902 P. 558
PK in W Face UP NW 117.35'
PK in S Face UP NE 35.37'
PK in W Face UP SW 180.36'

L.C.R.C. L. 5509 P. 445
Centerline Hyd. NW 42.46'

Measure N. 2672.5 to A-6 (Survey L. 2302 P. 144 = 26731.1) (G.L.O. 2640)
Measure S. 2701.00 to A-8 (G.L.O. 2640)
Measure E. 2641.00 to B-7 T2N R13E (Cranberry Estates Sub = 2640.65)
Measure W 2579.15 to L-7 (G.L.O. 2640)
This corner location is common with M-7 T2N R12E.

ACCEPTED BY THE MACOMB COUNTY SURVEY PEER GROUP AS THE OFFICIAL CORNER UNDER MICHIGAN PUBLIC ACT 345 OF 1990 AT A MEETING HELD ON 8-30-94.
William E. Soderberg
WILLIAM E. SODERBERG, P.S., CHAIRMAN

Description of monument for corner and accessories established to perpetuate locating the position of the corner:

I replaced the found 5/8" Square Rod with a 3/4" x 24" Iron Rod w/2" diameter aluminum cap stamped "Macomb County Monument MI Act 345 #25854," also set Monument Box.

PK S Face Utl. Pole N 56° E 35.37'
Center Line Top Nut Fire Hyd. N 63° E 88.47'
PK W Face Utl. Pole S 17° W 180.29'
PK with Tag "GW #78157" NW Face Utl. Pole SW 44° W 46.87'
"+" Top Nut Fire Hyd. N 78° W 42.50'

STATE OF MICHIGAN
RANDY J. KOLEHOUSE
LAND SURVEYOR
No. 25854
LICENSED LAND SURVEYOR

The selected location is accepted by me and is generally accepted by professional surveyors as the best available evidence of the position of the original corner.

ned by Randy J Kolehouse Date 10/14/94
veyor's Michigan License No. 25854

FORM APPROVED BY MICHIGAN STATE BOARD OF LAND SURVEYORS, JAN. 28, 1971
REVISED MAY 14, 1975
REVISED JAN., 1983