

**LAND CORNER RECORDATION CERTIFICATE**  
**Filing Requirement of Act 74, Mich. P.A. 1970**

or corners in

<u>MACOMB</u> (County)	Located in: Clinton Township	Corner Code #
Public Land Survey	T <u>2N</u> R <u>13E</u>	<u>A-10</u>
	T _____ R _____	_____
	T _____ R _____	_____
	T _____ R _____	_____
Property Controlling in Section	S _____ T _____ R _____	_____
Miscellaneous Property in Sec.	S _____ T _____ R _____	_____


**SURVEY &  
REMONUMENTATION**

FEB 27 1997

**COMMISSION**

Register of Deeds Stamp & File Number

Lot No. \_\_\_\_\_, Recorded Plat \_\_\_\_\_  
 Private Claims \_\_\_\_\_

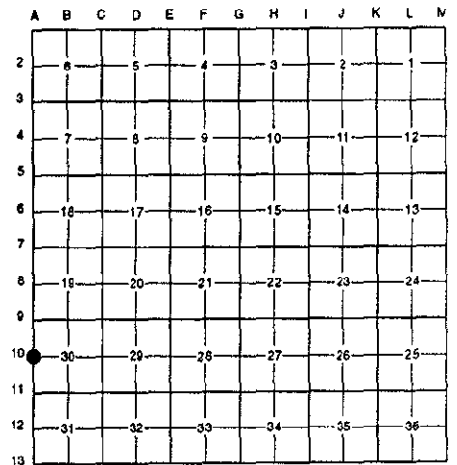

Randy Kolehouse, in a field survey on April 24 19 96,  
 hereby certify that under requirements of P.A. 74 Michigan P.A. of 1970, the corner points mentioned  
 lines 1 and 2 above were in conformance with regulations and rules therefore as required in the  
 current manual of survey instructions of the United States Department of the Interior, Bureau of Land  
 Management or by a decree of a Court of Law and/or that the corner points mentioned in lines 3, 4 and 5  
 above were in conformance with the rules of the Michigan Board of Land Surveyors or by a Decree of a  
 Court of Law; established, re-established, monumented, re-monumented, recovered, found as  
 expressed below:

**NOTE: Not more than 4 corners, all in the same town and range, may be recorded  
 on this certificate.**

Description of original monument and accessories and/or subsequent restoration:

10 Records indicate this corner is common with M-10, T2N, R12E.

1817	G.L.O. Notes	Preston	N/A	Small Beech
1983	L.C.R.C. L. 3475 P. 114	#14095	Kattouah	Set 1/2" Capped Iron

Description of corner evidence found and/or method applied in restoring or reestablishing corner:

10 I found a 1/2" rebar w/cap No. 14095 15' ± South of the C/L of a drain which checks with the witnesses. This iron is on a  
 straight line ± between M-9 and M-11. Also found iron pipe (no information on record) 0.19' NW'ly. No witnesses were  
 given in Preston's G.L.O. notes.

L.C.R.C. L. #3475 P. 114  
 P.K. Nail N. Face, 18" Oak West 30.74 Ft. (m. 30.71')  
 South 31.17 Ft. P.K. Nail N. Face, Twin 12" Cherry  
 P.K. Nail N. Face, T.R1, 12" Basswood East 3.25 Ft. (m. 3.49')  
 East 33.11 Ft., Nail S. Face-Quad 15" Basswood (m. 33.04')

ACCEPTED BY THE MACOMB COUNTY SURVEY PEER  
 GROUP AS THE OFFICIAL CORNER UNDER MICHIGAN  
 PUBLIC ACT 345 OF 1990 AT A MEETING HELD  
 ON 9-17-96

*William E. Soderberg*  
 WILLIAM E. SODERBERG, P.S., CHAIRMAN

Measure North 2776.14' to A-9 (G.L.O. = 2640.0')  
 Measure South 2727.63' to A-11 (G.L.O. = 2640.0')

Description of monument for corner and accessories established to perpetuate locating the position of the corner:


10 I replaced the found 1/2" capped iron with a 4" x 36" concrete monument w/2" diameter aluminum cap stamped "Macomb  
 County Monument MI Act 345 #25854."

- S 84° E 33.04' - Found Nail and Macomb Co. Remon. Tag in S Face 20" Quad. Tree
- S 79° E 3.49' - Found Nail and Macomb Co. Remon. Tag in N Face 18" Triple Tree
- S 06° W 31.17' - Found Nail and Macomb Co. Remon. Tag in W Face 18" Cherry
- N 86° W 30.71' - Found Nail and Macomb Co. Remon. Tag in N Face 20" Oak

The selected location is accepted by me and is generally accepted by professional surveyors  
 as the best available evidence of the position of the original corner.

Recorded by Randy J. Kolehouse  
 Surveyor's Michigan License No. 25854

Date 11/19/96

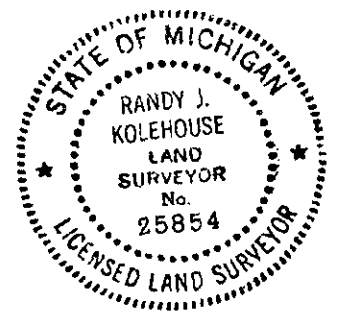

632