

LAND CORNER RECORDATION CERTIFICATE
Filing Requirement of Act 74, Mich. P.A. 1970

B997888

93 DEC 22 AM 9:04

For corners in

<u>MACOMB</u> <small>(County)</small>	Located In:	Corner Code #
	<u>CLINTON TWP.</u>	
1. Public Land Survey	T <u>2N</u> R <u>13E</u>	<u>B-3</u>
	T _____ R _____	_____
	T _____ R _____	_____
	T _____ R _____	_____
2. Property Controlling in Section	S _____ T _____ R _____	<i>Seg #1</i>
	S _____ T _____ R _____	
	S _____ T _____ R _____	
3. Miscellaneous Property in Sec.	S _____ T _____ R _____	_____
4. Lot No. _____, Recorded Plat _____		
5. Private Claims _____		

CARMELLA SABAUGH
REGISTER OF DEEDS
MACOMB COUNTY, MI

LIBER 06161 PG 238

Register of Deeds Stamp & File Number

I, BRUCE ANTCLIFF, in a field survey on NOVEMBER .22, 19 93, do hereby certify that under requirements of P.A. 74, Michigan P.A. of 1970, the corner points mentioned in lines 1 and 2 above were in conformance with regulations and rules therefore as required in the current manual of survey instructions of the United States Department of the Interior, Bureau of Land Management or by a decree of a Court of Law and/or that the corner points mentioned in lines 3, 4 and 5 above were in conformance with the rules of the Michigan Board of Land Surveyors or by a Decree of a Court of Law; established, re-established, monumented, re-monumented, recovered, found as expressed below:

A	B	C	D	E	F	G	H	I	J	K	L	M
2	6	5	4	3	2	1						
3	•											
4	7	8	9	10	11	12						
5												
6	18	17	16	15	14	13						
7												
8	19	20	21	22	23	24						
9												
10	30	29	28	27	26	25						
11												
12	31	32	33	34	35	36						

NOTE: Not more than 4 corners, all in the same town and range, may be recorded on this certificate.

A. Description of original monument and accessories and/or subsequent restoration:

- | | | |
|--|--|---|
| GLO-Post, NO WITS. REMAIN
MCRC (1974)-1/2" IRON
PK IN DE POLE, NW, 69.45'
PK IN TWIN 13" TREE, NNE, 25.21'
PK IN MB POLE, SE, 62.64'
PK IN 20" TREE, SSE, 26.20' | EDISON NOTES(1982)-1/2" PIN/MON BOX
PK SW FACE LP, N40W, 56.73'
PK SE FACE DE POLE, S60W, 74.89'
NE COR FDN HSE #15980, S45W, 114.75'
LCRC (1972) L2279,P374-1/2" IRON BAR
N&T IN DE POLE, NW, 69.95'
N&T IN MBT POLE, SE, 63.26'
PK IN 24" HICKORY, SE, 27.01' | LCRC (1979) L3184,P577-1/2" REBAR/MON BOX
PK TOP OF CUR @ PC, NE, 69.81'
PK IN DE POLE, SE, 133.34'
PK IN DE POLE, SW, 74.93'
PK IN LIGHT POLE, NW, 56.66'
IRON, WEST, 2668.21
LCRC(1989) L4687,P331-1/2" ROD/MON BOX
PK SW FACE LIGHT POLE, NW, 56.91'
PK N END CURB RETURN, NE, 64.26'
PK NE FACE UTIL POLE, SE, 113.38'
PK SE FACE UTIL POLE, SW, 74.79' |
| AVENDT SURVEY-NO DATE-1/2" IRON
PK IN 24" HICKORY, SSE, 27.02'
PK IN 28" ASH, ENE, 104.60'
PK IN TWIN 10" ASH, NORTH, 26.39'
NE COR FTNG HSE #15980, SW, 114.81'
N&T IN PP, NW, 69.95 | LCRC (1973) L2464,P468-#4 REBAR
PK W SIDE 24" HICKORY, SSE, 27.01'
PK E SIDE TWIN 8" ASH, NORTH, 26.43'
NE COR HSE #15980, SW, 114.7'; 2639.51' TO C-3 | |

B. Description of corner evidence found and/or method applied in restoring or reestablishing corner:
 FOUND 1/2" ROD/CONC. MON. IN MON. BOX


FOUND AND VERIFIED THREE OF THE ABOVE WITNESSES

**ACCEPTED BY THE MACOMB COUNTY
 SURVEY PEER GROUP AS THE OFFICIAL
 CORNER UNDER MICHIGAN PUBLIC ACT 345
 OF 1990 AT A MEETING HELD ON
 12-1-93**

Frank J. DeDecker
FRANK J. DeDECKER, PS, PE, CHAIRMAN

C. Description of monument for corner and accessories established to perpetuate locating the position of the corner:

- SET MACOMB COUNTY REMONUMENTATION CAP #25826 IN EXIST. MON. BOX.
 WITNESSES
 FND PK SE FACE LP, N32W, 56.78'
 FND PK SE FACE PP, S55W, 75.03'
 NE COR. OFFICE BLDG #15980, S51W, 125.52'
 FND PK NE FACE PP, S64E, 133.25'

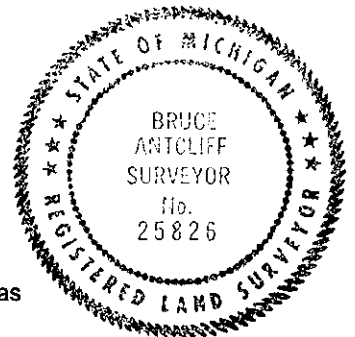

The selected location is accepted by me and is generally accepted by Professional Surveyors as the best available evidence of the position of the original corner.

Signed by Bruce Antcliff Date 12-9-93

Surveyor's Michigan License No. 25826