

SURVEY & REMONUMENTATION

APR 28 1995

C152213

LAND CORNER RECORDATION CERTIFICATE

COMMISSION Filing Requirement of Act 74, Mich. P.A. 1970

For corners in
MACOMB
(County)

Located In: Clinton Township Corner Code: B-5

- | | | | | | | | | | |
|------------------------------------|-------------|--------------|---------|--|--|--|--|--|--|
| 1. Public Land Survey | T <u>2N</u> | R <u>13E</u> | | | | | | | |
| | T _____ | R _____ | | | | | | | |
| | T _____ | R _____ | | | | | | | |
| | T _____ | R _____ | | | | | | | |
| 2. Property Controlling in Section | S _____ | T _____ | R _____ | | | | | | |
| | S _____ | T _____ | R _____ | | | | | | |
| 3. Miscellaneous Property in Sec. | S _____ | T _____ | R _____ | | | | | | |
| | S _____ | T _____ | R _____ | | | | | | |


LIBER **6527** PAGE **790**

94 DEC 11, AM 10:51

MACOMB COUNTY, MI
REGISTER OF DEEDS

Register of Deeds Stamp & File Number

4. Lot No. _____, Recorded Plat _____
5. Private Claims _____

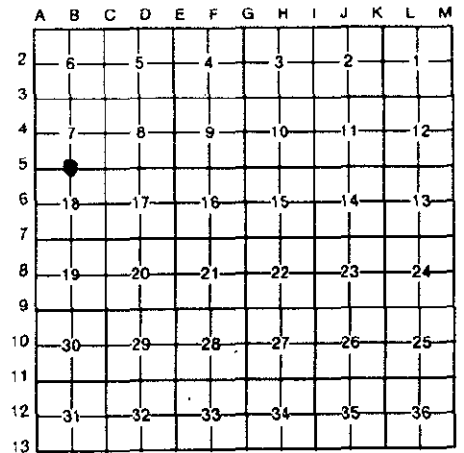

I, Randy Kolehouse, in a field survey on July 27, 19 94, do hereby certify that under requirements of P.A. 74, Michigan P.A. of 1970, the corner points mentioned in lines 1 and 2 above were in conformance with regulations and rules therefore as required in the current manual of survey instructions of the United States Department of the Interior, Bureau of Land Management or by a decree of a Court of Law and/or that the corner points mentioned in lines 3, 4 and 5 above were in conformance with the rules of the Michigan Board of Land Surveyors or by a Decree of a Court of Law; established, re-established, monumented, re-monumented, recovered, found as expressed below:

NOTE: Not more than 4 corners, all in the same town and range, may be recorded on this certificate.

A. Description of original monument and accessories and/or subsequent restoration:

B-5	1817	G.L.O.	Notes	Preston	NA	Post
	1973	L.C.R.C.	L. 2464 P. 464	South	#20623	3/4" Bar
	1978	L.C.R.C.	L. 2902 P. 559	Soderberg	#17635	1" Steel Form Pin
	1988	L.C.R.C.	L. 4369 P. 430	Soderberg	#17635	3/4" Steel Bar

B. Description of corner evidence found and/or method applied in restoring or reestablishing corner:

B-5 Found 3/4" rod in Monument Box at center line at 18 Mile Road on plat line north and south.

L.C.R.C. L. 2464 P. 464
Conc. Mon. N 59.96'
NW Cor. Hse. #15950 WSW 174.97'

L.C.R.C. L. 4369 P. 430
Conc. Mon. S 60.00'
Conc. Mon. N 60.09'
PK in E Face Util. Pole N 61.41'

L.C.R.C. L. 2902 P. 559
PK in E Face Util. Pole N 61.31'

Measure W 2613.78 to A-5 (G.L.O. 2593.8)
Measure E 2676.55 to C-5 (G.L.O. 2640.0)


ACCEPTED BY THE MACOMB COUNTY SURVEY PEER
GROUP AS THE OFFICIAL CORNER UNDER MICHIGAN
PUBLIC ACT 345 OF 1990 AT A MEETING HELD
ON 9-20-94

William E. Soderberg
WILLIAM E. SODERBERG, P.S., CHAIRMAN

C. Description of monument for corner and accessories established to perpetuate locating the position of the corner:

B-5 I replaced the found 3/4" Rod with a 3/4" x 24" Iron Rod w/2" diameter aluminum cap stamped "Macomb County Monument MI Act 345 #25854" in an existing Monument Box.

Con. Mon. S 06° W 60.01'
Conc. Mon. N 07° E 59.94'
PK E Face Util. Pole N 06° E 61.20
PK & Macomb Co. Remon. Tag in S'ly Face 24" Oak N 75° E 115.07'
PK & Macomb Co. Remon. Tag in S'ly Face 8" Maple N 62° W 118.23'

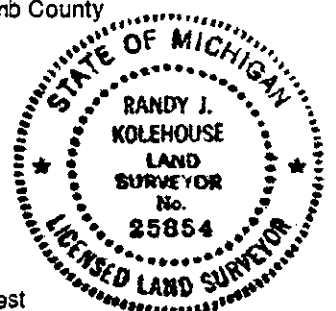

The selected location is accepted by me and is generally accepted by professional surveyors as the best available evidence of the position of the original corner.

Signed by Randy J. Kolehouse
Surveyor's Michigan License No. 25854

Date 10/14/94