

SURVEY & REMONUMENTATION

APR 28 1995

LAND CORNER RECORDATION CERTIFICATE

C152214

Filing Requirement of Act 74, Mich. P.A. 1970

For corners in

COMMISSION

LIBER 6527 PAGE 791

MACOMB
(County)

Located In: Clinton Township


Corner Code: B-7

- | | | | | | |
|------------------------------------|--------------------------|--|--|--|--|
| 1. Public Land Survey | T <u>2N</u> R <u>13E</u> | | | | |
| | T _____ R _____ | | | | |
| | T _____ R _____ | | | | |
| | T _____ R _____ | | | | |
| 2. Property Controlling in Section | S _____ T _____ R _____ | | | | |
| | S _____ T _____ R _____ | | | | |
| 3. Miscellaneous Property in Sec. | S _____ T _____ R _____ | | | | |
| | S _____ T _____ R _____ | | | | |

94 DEC 14 1110: 51
CARR REGISTER MACOMB
AUG 1994 DEEDS PARTY, MI

Register of Deeds Stamp & File Number

4. Lot No. _____, Recorded Plat _____
5. Private Claims _____

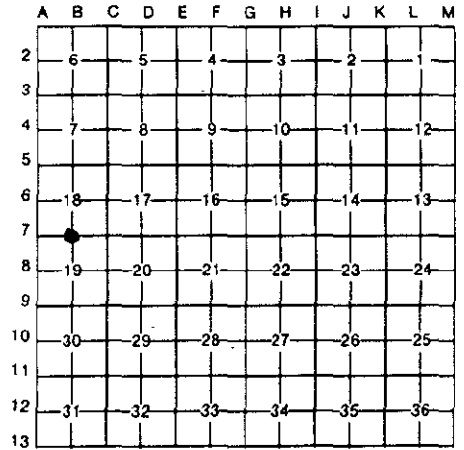

I, Randy Kolehouse, in a field survey on July 26, 19 94, do hereby certify that under requirements of P.A. 74, Michigan P.A. of 1970, the corner points mentioned in lines 1 and 2 above were in conformance with regulations and rules therefore as required in the current manual of survey instructions of the United States Department of the Interior, Bureau of Land Management or by a decree of a Court of Law and/or that the corner points mentioned in lines 3, 4 and 5 above were in conformance with the rules of the Michigan Board of Land Surveyors or by a Decree of a Court of Law; established, re-established, monumented, re-monumented, recovered, found as expressed below:

NOTE: Not more than 4 corners, all in the same town and range, may be recorded on this certificate.

A. Description of original monument and accessories and/or subsequent restoration:

| | | | | | | |
|-----|------|----------|----------------|-----------|--------|-------------------------------|
| B-7 | 1817 | G.L.O. | Notes | Preston | NA | Post |
| | 1974 | MCRC | File #90 | Rivard | | 2-1/2" Irons (Southerly of 2) |
| | 1976 | L.C.R.C. | L. 2902 P. 558 | Soderberg | #17635 | 1/2" Rerod |

B. Description of corner evidence found and/or method applied in restoring or reestablishing corner:

B-7 Found 1/2" rerod in monument box at center line of 17 Mile Road.

| | |
|---|--|
| MCRC #90 SW Cor. E Most Brick Pillar NW'ly 69.82' | L.C.R.C. L. 2902 P. 558 |
| PK in W Face D.E. Pole S'ly 25.71' (Hole Only) | PK in W Face Util. Pole S 25.80' |
| PK in W Face D.E. Pole S'ly 25.63' (Hole Only) | Center Line Top Nut Hyd. SW 190.95' |
| | (Hyd. is NW, not SW) |
| | SE Cor. E Most Brick Pillar NW'ly 67.88' |

Measure W 2641.00 to A-7 (MCRC 2641.27) (Cranberry Est. 2640.65) (G.L.O. 2600.4)
Measure E 2649.92 to C-7 (MCRC 2649.88) (G.L.O. 2640.0)

C. Description of monument for corner and accessories established to perpetuate locating the position of the corner:

B-7 I replaced the found 1/2" rerod with a 3/4" x 24" Iron Rod w/2" diameter aluminum cap stamped "Macomb County Monument MI Act 345 #25854" in an existing Monument Box.

PK NW Face Util. Pole N 60° E 43.11'
SE Cor. E Most Brick Pillar N 25° W 67.76'
Center Line Top Nut Hyd. N 76° W 190.84'
PK & Macomb Co. Remon. Tag W Face Util. Pole S 10° W 25.82'
PK & Macomb Co. Remon. Tag S Face Lt. Pole N 70° W 123.32'

ACCEPTED BY THE MACOMB COUNTY SURVEY PEER GROUP AS THE OFFICIAL CORNER UNDER MICHIGAN PUBLIC ACT 345 OF 1890 AT A MEETING HELD ON 9-20-94
William E. Soderberg
WILLIAM E. SODERBERG, P.S., CHAIRMAN

The selected location is accepted by me and is generally accepted by professional surveyors as the best available evidence of the position of the original corner.

Signed by Randy J. Kolehouse
Surveyor's Michigan License No. 25854

Date 10/14/94

