

**SURVEY &  
REMONUMENTATION**

**C152215**

**APR 28 1995**

**LAND CORNER RECORDATION CERTIFICATE**

LIBER **6527** PAGE **792**

**Filing Requirement of Act 74, Mich. P.A. 1970**

For corners in  
**MACOMB**  
(County)

**COMMISSION**

Located In: **Clinton Township** Corner Code **#**


|                                    |                          |            |
|------------------------------------|--------------------------|------------|
| 1. Public Land Survey              | T <u>2N</u> R <u>13E</u> | <u>B-9</u> |
|                                    | T _____ R _____          | _____      |
|                                    | T _____ R _____          | _____      |
|                                    | T _____ R _____          | _____      |
| 2. Property Controlling in Section | S _____ T _____ R _____  | _____      |
|                                    | S _____ T _____ R _____  | _____      |
| 3. Miscellaneous Property in Sec.  | S _____ T _____ R _____  | _____      |
|                                    | S _____ T _____ R _____  | _____      |

94 DEC 11 AM 10:51  
REGISTERED  
DEEDS  
MICH. ST.

Register of Deeds Stamp & File Number

4. Lot No. \_\_\_\_\_, Recorded Plat \_\_\_\_\_  
5. Private Claims \_\_\_\_\_

I, Randy Kolehouse, in a field survey on Sept. 14, 19 94, do hereby certify that under requirements of P.A. 74, Michigan P.A. of 1970, the corner points mentioned in lines 1 and 2 above were in conformance with regulations and rules therefore as required in the current manual of survey instructions of the United States Department of the Interior, Bureau of Land Management or by a decree of a Court of Law and/or that the corner points mentioned in lines 3, 4 and 5 above were in conformance with the rules of the Michigan Board of Land Surveyors or by a Decree of a Court of Law; established, re-established, monumented, re-monumented, recovered, found as expressed below:

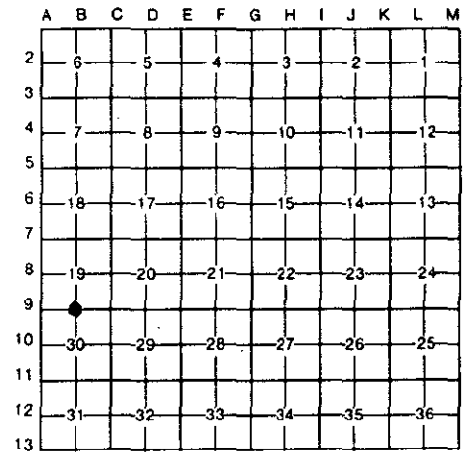

**NOTE: Not more than 4 corners, all in the same town and range, may be recorded on this certificate.**

**A. Description of original monument and accessories and/or subsequent restoration:**

|     |      |                 |         |         |        |                |
|-----|------|-----------------|---------|---------|--------|----------------|
| B-9 | 1817 | G.L.O.          | Notes   | Preston | NA     | Post           |
|     | 1980 | Cert. of Survey | #79/848 | Coulter | #14780 | Conc. Monument |
|     | 1980 | Lehner Assoc.   | Notes   | NA      | NA     | Conc. Monument |

**B. Description of corner evidence found and/or method applied in restoring or reestablishing corner:**

B-9 Found 1/2" rebar with cap #30103 in a garden behind house #16002 Timberview. Checks distances as shown in Lot 17 Monterey Subdivision L. 82 P. 33, Macomb County Records.

Survey 79/848

Survey Notes - Lehner Assoc.

PK Nail in 16" Tree South 31.12'  
PK Nail in 24" Tree West 36.12'

PK N Side 24" Oak West 36.15'  
PK W Side 18" Ash SSW 31.10'


Measure West to A-9 = 2720.04 (G.L.O. 2640) (Monterey Sub. 2725.30)  
Measure East to C-9 = 2669.97 (G.L.O. 2640) (Monterey Sub. 2670.27)

ACCEPTED BY THE MACOMB COUNTY SURVEY PEER GROUP AS THE OFFICIAL CORNER UNDER MICHIGAN PUBLIC ACT 345 OF 1990 AT A MEETING HELD ON 10-4-94  
William E. Soderberg  
WILLIAM E. SODERBERG, P.S., CHAIRMAN

**C. Description of monument for corner and accessories established to perpetuate locating the position of the corner:**

B-9 I replaced the found 1/2" rebar with a 3/4" x 24" Iron Rod w/2" diameter aluminum cap stamped "Macomb County Monument MI Act 345 #25854."

Double Head Nail with Tag #30103 in W Face 20" Ash S 15° W 30.07'  
Double Head Nail with Tag # 30103 in W Face Ash S 60° W 44.13'  
PK & Macomb Co. Remon. Tag N Face 28" Oak N 75° W 35.89'  
NW Cor. Brick Garage for House #16002 N 12° E 16.15'  
Near Face Garage Perpendicular to Wall N 50° E 12.34'

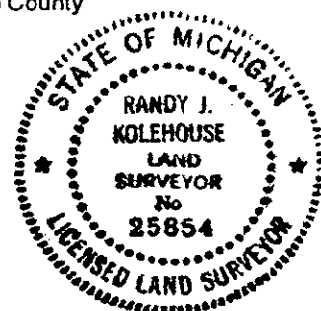

The selected location is accepted by me and is generally accepted by professional surveyors as the best available evidence of the position of the original corner.

Signed by Randy J. Kolehouse  
25854  
Surveyor's Michigan License No. \_\_\_\_\_

Date 10/14/94