

LAND CORNER RECORDATION CERTIFICATE
Filing Requirement of Act 74, Mich. P.A. 1970

B997891


For corners in

<u>MACOMB</u> <small>(County)</small>	Located in:	Corner Code #
	CLINTON TWP.	
1. Public Land Survey	T <u>2N</u> R <u>13E</u>	<u>C-3</u>
	T _____ R _____	_____
	T _____ R _____	_____
	T _____ R _____	_____
2. Property Controlling in Section	S _____ T _____ R _____	_____
	S _____ T _____ R _____	_____
3. Miscellaneous Property in Sec.	S _____ T _____ R _____	_____
	S _____ T _____ R _____	_____
4. Lot No. _____, Recorded Plat _____		
5. Private Claims _____		

LIBER **06161PG241**

Register of Deeds Stamp & File Number

I, BRUCE ANTCLIFF, in a field survey on NOVEMBER 22, 1993, do hereby certify that under requirements of P.A. 74, Michigan P.A. of 1970, the corner points mentioned in lines 1 and 2 above were in conformance with regulations and rules therefore as required in the current manual of survey instructions of the United States Department of the Interior, Bureau of Land Management or by a decree of a Court of Law and/or that the corner points mentioned in lines 3, 4 and 5 above were in conformance with the rules of the Michigan Board of Land Surveyors or by a Decree of a Court of Law; established, re-established, monumented, re-monumented, recovered, found as expressed below:

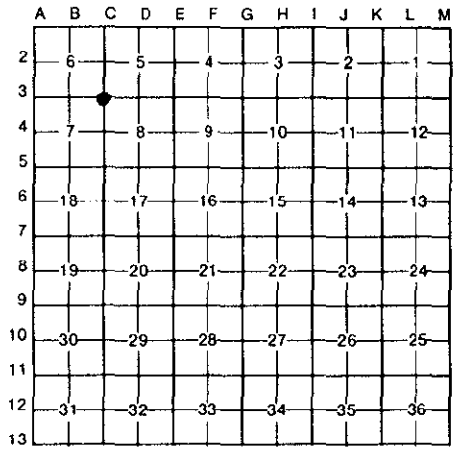

NOTE: Not more than 4 corners, all in the same town and range, may be recorded on this certificate.

- A. Description of original monument and accessories and/or subsequent restoration:
- GLO-Post, NO WITS. REMAIN
 - MCRC (1974)-1" IRON/MON
PK IN DE POLE, NW, 116.03'
PK IN DE POLE, SW, 66.16'
PK IN MBT POLE, SE, 80.38'
PK IN FENCE POST, NE, 74.38'
 - LCRC (1978) L3003, P830-1/2" IRON/MON BOX
MCRC N&T DE POLE, SW, 66.08'
PK NW FACE DE POLE, NE, 65.54'
N&T NE FACE DE POLE, SE, 81.05'
PK IN NE FACE DE POLE, NW, 116.75'
 - LCRC (1979) L3197, P101-1" BAR/MON BOX
CENTER OF GATEWELL, NE, 53.35'
CENTER OF GATEWELL, NW, 52.10'
N&T #20623 SE SIDE POLE, SW, 66.82'
PK&T E SIDE POLE, SE, 81.10'
 - LCRC (1987) L4113, P178-IRON/MON BOX
CENTER OF GATEWELL, NE, 53.35'
CENTER OF GATEWELL, NW, 52.10'
N&T #20623 SE FACE PP, SW, 66.82'
CENTER OF STORM MH, SE, 53.75'
 - LCRC (1989) L4723, P603-3/4" ROD/MON BOX
MCRC TAG E FACE SIGNAL POLE, N47E, 67.32'
RJD TAG NE FACE MBT POLE, S31E, 86.82'
N&T #20623 E FACE DE POLE, S45W, 66.82'
MCRC TAG W FACE DE POLE, N17W, 116.27'


- B. Description of corner evidence found and/or method applied in restoring or reestablishing corner:
FOUND 1/2" REBAR/MON. BOX
- FOUND AND VERIFIED FOUR OF THE ABOVE WITNESSES.**

ACCEPTED BY THE MACOMB COUNTY SURVEY PEER GROUP AS THE OFFICIAL CORNER UNDER MICHIGAN PUBLIC ACT 345 OF 1990 AT A MEETING HELD ON
12-1-93

Frank J. DeDecker
FRANK J. DeDECKER, PS, PE, CHAIRMAN

93 DEC 22 AM 9: 05
 CARMELLA SABAUGH
 REGISTER OF DEEDS
 MACOMB COUNTY, MI

- C. Description of monument for corner and accessories established to perpetuate locating the position of the corner:
- SET MACOMB COUNTY REMONUMENTATION MARKER AND CAP #25826 IN EXIST. MON. BOX.**
- WITNESSES**
- FND MCRC N&T E FACE SIG. POLE, N52E, 67.29'
 - FND DAVERMAN TAG IN PP, S50W, 66.76'
 - FND MCRC N&T W FACE PP, N12W, 116.29'
 - FND N&T (RJD) NE FACE MBT POLE, S26E, 86.79'

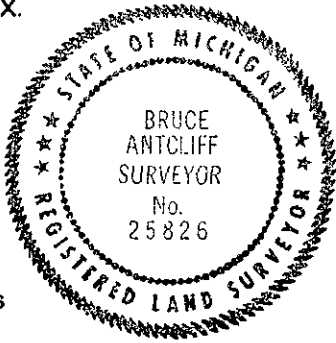

The selected location is accepted by me and is generally accepted by Professional Surveyors as the best available evidence of the position of the original corner.

Signed by Bruce Antcliff Date 12-9-93
 Surveyor's Michigan License No. 25826