SURVEY &
REMONUMENTATION

APR 2 8 1995
COMMISSION

C152219

94 DEC 14 AM 10: 52

REGISTER OF DEEDS
MACOMB COUNTY, MI

LIBER 6527 PAGE 796

Register of Deeds Stamp & File Number

LAND CORNER RECORDATION CERTIFICATE

Filing Requirement of Act 74, Mich. P.A. 1970

For corners in MACOMB (County) Located In: Clinton Township Corner Code ##

1. Public Land Survey T 2N R 13E C-7
   T ___ R ___
   T ___ R ___
   T ___ R ___
2. Property Controlling S ___ T ___ R ___
   in Section S ___ T ___ R ___
3. Miscellaneous S ___ T ___ R ___
   Property in Sec. S ___ T ___ R ___

4. Lot No. _____, Recorded Plat _____
5. Private Claims _____

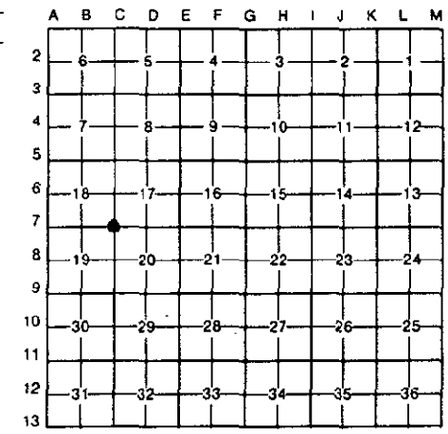

I, Randy Kolehouse, in a field survey on July 26, 19 94, do hereby certify that under requirements of P.A. 74, Michigan P.A. of 1970, the corner points mentioned in lines 1 and 2 above were in conformance with regulations and rules therefore as required in the current manual of survey instructions of the United States Department of the Interior, Bureau of Land Management or by a decree of a Court of Law and/or that the corner points mentioned in lines 3, 4 and 5 above were in conformance with the rules of the Michigan Board of Land Surveyors or by a Decree of a Court of Law; established, re-established, monumented, re-monumented, recovered, found as expressed below:

NOTE: Not more than 4 corners, all in the same town and range, may be recorded on this certificate.

A. Description of original monument and accessories and/or subsequent restoration:

C-7	1817	G.L.O.	Notes	Preston	NA	Post
	1972	L.C.R.C.	L. 2314 P. 677	Avendt	#16034	1/2" Iron in Mon. Box
	1972	Survey	L. 2314 P. 672	Avendt	#16034	1/2" Iron in Mon. Box
	1972	L.C.R.C.	L. 2327 P. 143	Smith	#16052	1/2" Iron in Mon. Box
	1972	Survey	L. 2327 P. 136	Smith	#16052	1/2" Iron in Mon. Box
	1973	L.C.R.C.	L. 2474 P. 630	Avendt	#16034	1/2" Iron in Mon. Box
	1973	Survey	L. 2474 P. 629	Avendt	#16034	1/2" Iron in Mon. Box

B. Description of corner evidence found and/or method applied in restoring or reestablishing corner:

C-7 Found 5/8" Iron in Monument Box at center line intersection of Garfield Road and 17 Mile Road which checks Thorton Subdivision.

All witnesses have been destroyed.

Measure N 2692.14 to C-6 (MCRC 2689.6) (G.L.O. 2640)
Measure E 2681.55 to D-7 (Thorton Sub. = 2681.65) (G.L.O. 2640.0)
Measure S (G.L.O. No Dist. Given)
Measure W 2649.92 to B-7 (G.L.O. 2640.0)

ACCEPTED BY THE MACOMB COUNTY SURVEY PEER GROUP AS THE OFFICIAL CORNER UNDER MICHIGAN PUBLIC ACT 345 OF 1990 AT A MEETING HELD ON 9-20-94
William E. Soderberg
WILLIAM E. SODERBERG, P.S., CHAIRMAN

C. Description of monument for corner and accessories established to perpetuate locating the position of the corner:

C-7 I replaced the found 5/8" Iron with a 3/4" x 24" Iron Rod w/2" diameter aluminum cap stamped "Macomb County Monument MI Act 345 #25854" in an existing Monument Box.

PK SW Face Utl. Pole N 45° W 64.22'
PK SE Face Utl. Pole S 57° W 64.13'
PK NE Face Utl. Pole S 40° E 65.25'
PK & Macomb Co. Remon. Tag NW Face Utl. Pole N 45° E 66.74'

STATE OF MICHIGAN
RANDY J. KOLEHOUSE
LAND SURVEYOR
No. 25854
LICENSED LAND SURVEYOR

The selected location is accepted by me and is generally accepted by professional surveyors as the best available evidence of the position of the original corner.

Signed by Randy J. Kolehouse Date 10/14/94

Surveyor's Michigan License No. 25854

FORM APPROVED BY MICHIGAN STATE BOARD OF LAND SURVEYORS, JAN. 28, 1971
REVISED MAY 14, 1975
REVISED JAN., 1983