SURVEY &
REMONUMENTATION

APR 2 8 1995

COMMISSION

C152222

94 DEC 14 AM 10: 52

LAND CORNER RECORDATION CERTIFICATE

Filing Requirement of Act 74, Mich. P.A. 1970

For corners in MACOMB (County) Located In: Clinton Township Corner Code ##

1. Public Land Survey		T 2N	R 13E	C-9
		T ____	R ____	
		T ____	R ____	
		T ____	R ____	
2. Property Controlling	S ____	T ____	R ____	
in Section	S ____	T ____	R ____	
3. Miscellaneous	S ____	T ____	R ____	
Property in Sec.	S ____	T ____	R ____	

LIBER 6527 PAGE 799

Register of Deeds Stamp & File Number

4. Lot No. _____ , Recorded Plat _____
5. Private Claims _____

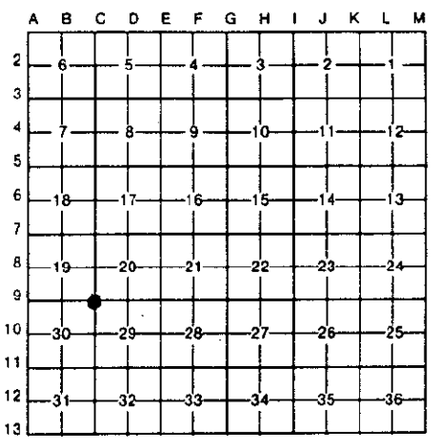

I, Randy Kolehouse, in a field survey on July 28, 19 94, do hereby certify that under requirements of P.A. 74, Michigan P.A. of 1970, the corner points mentioned in lines 1 and 2 above were in conformance with regulations and rules therefore as required in the current manual of survey instructions of the United States Department of the Interior, Bureau of Land Management or by a decree of a Court of Law and/or that the corner points mentioned in lines 3, 4 and 5 above were in conformance with the rules of the Michigan Board of Land Surveyors or by a Decree of a Court of Law; established, re-established, monumented, re-monumented, recovered, found as expressed below:

NOTE: Not more than 4 corners, all in the same town and range, may be recorded on this certificate.

A. Description of original monument and accessories and/or subsequent restoration:

C-9	1817	G.L.O.	Notes	Preston	NA	Post
	1969	MCRC	File #115			Iron in Mon. Box
	1988	L.C.R.C.	L. 4790 P. 792	Soderberg	#17635	3/8" Rebar in Conc. Pvmt.
		MCRC Prints Garfield Road from Metro Pkwy. to 17 Mile Road				5/8" Iron Rod in Mon. Box

B. Description of corner evidence found and/or method applied in restoring or reestablishing corner:

C-9 Found 3/8" rebar in center line of Garfield at north right-of-way of Metro Parkway per MCRC Road Plans.

L.C.R.C. L. 4790 P. 792
B.O.C. Garfield Road W 40.00'
B.O.C. Garfield Road E 28.95'
Nail with MCRC Tag S Face Util. Pole WNW 50.67'

MCRC Plans
Conc. Mon. West 60.00'
Center Line Cover M.H. NE'ly 58.00'

Measure North to C-8 2668.00' (G.L.O. 2640)
Measure West to B-9 2669.97 (Monterey Sub. 2670.27) (G.L.O. 2640)

ACCEPTED BY THE MACOMB COUNTY SURVEY PEER GROUP AS THE OFFICIAL CORNER UNDER MICHIGAN PUBLIC ACT 345 OF 1990 AT A MEETING HELD ON 10-4-94.
William E. Soderberg
WILLIAM E. SODERBERG, P.S., CHAIRMAN

C. Description of monument for corner and accessories established to perpetuate locating the position of the corner:

C-9 I replaced the found 3/8" Rod with a 3/4" x 24" Iron Rod w/2" diameter aluminum cap stamped "Macomb County Monument MI Act 345 #25854," also set Monument Box.

PK N Face Signal Pole W.B. Metro Pkwy. S 48° E 52.13'
PK with Tag "W.E.S." #17635 NW Face Lt. Pole S 64° W 81.98'
1/2" ID Pipe N 82° W 60.00'
PK with MCRC Tag S Face Util. Pole (Flush with Face of Pole) N 72° W 50.62'
PK & Macomb Co. Remon. Tag N Face Util. Pole N 77° E 53.90'

STATE OF MICHIGAN
RANDY J. KOLEHOUSE
LAND SURVEYOR
No. 25854
LICENSED LAND SURVEYOR

The selected location is accepted by me and is generally accepted by professional surveyors as the best available evidence of the position of the original corner.

Signed by Randy J. Kolehouse Date 10/14/94

Surveyor's Michigan License No. 25854

FORM APPROVED BY MICHIGAN STATE BOARD OF LAND SURVEYORS, JAN. 28, 1971
REVISED MAY 14, 1975
REVISED JAN., 1983