

LAND CORNER RECORDATION CERTIFICATE
 Filing Requirement of Act 74, Mich. P.A. 1970


For corners in

<u>MACOMB</u> (County)	Located in: Clinton Township	Corner Code #
1. Public Land Survey	T <u>2N</u> R <u>13E</u>	<u>D-1</u>
	T _____ R _____	_____
	T _____ R _____	_____
	T _____ R _____	<u>See #2 pm</u>
2. Property Controlling in Section	S _____ T _____ R _____	_____
	S _____ T _____ R _____	_____
3. Miscellaneous Property in Sec.	S _____ T _____ R _____	_____
	S _____ T _____ R _____	_____
4. Lot No. _____, Recorded Plat _____		
5. Private Claims _____		

Register of Deeds Stamp & File Number

I, Randy Kolehouse, in a field survey on November 20 19 94, do hereby certify that under requirements of P.A. 74 Michigan P.A. of 1970, the corner points mentioned in lines 1 and 2 above were in conformance with regulations and rules therefore as required in the current manual of survey instructions of the United States Department of the Interior, Bureau of Land Management or by a decree of a Court of Law and/or that the corner points mentioned in lines 3, 4 and 5 above were in conformance with the rules of the Michigan Board of Land Surveyors or by a Decree of a Court of Law; established, re-established, monumented, re-monumented, recovered, found as expressed below:

NOTE: Not more than 4 corners, all in the same town and range, may be recorded on this certificate.

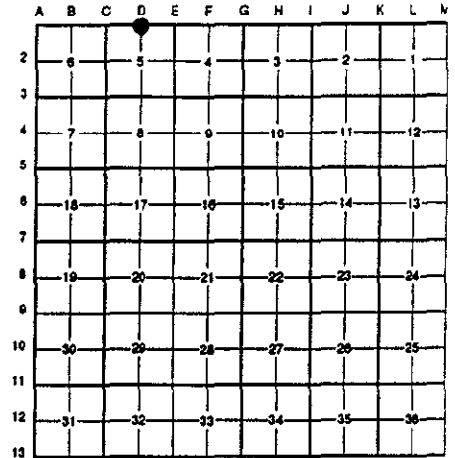

A. Description of original monument and accessories and/or subsequent restoration:

D-1	1817	G.L.O. Notes	Preston	N/A	Post
		AEW Field Notes	N/A	N/A	N/A
	1994	L.C.R.C. L. 6166 P. 015	Antcliff	#25826	5/8" Rebar w/Remon. Cap

B. Description of corner evidence found and/or method applied in restoring or reestablishing corner:

D-1 Point was destroyed during M-59 reconstruction. The point was reset on line between D-13 and E-13 of T3N R13E Macomb Township at recorded distance East of D-13 which agrees with the following witnesses.

LCRC L. 6166 P. 015

- SWM Tag/P.K. E Face P. Pole S 05° E 60.05'
- SWM Tag/P.K. NW Face P. Pole S 69° W 147.19'
- SWM Tag/P.K. NE Face P. Pole S 68° E 180.05'

- Measures East to E-1 = 2677.49' (WWES 1994 = 2677.62')
- Measures East to E-13 T3N R13E = 2073.69' (WWES 1994 = 2073.63')
- Measures West to D-13 T3N R13E = 597.17' (WWES 1994 = 597.13)
- Measures West to C-1 = 2677.30' (WWES 1994 = 2677.30' (WWES 1994 = 2677.30')

ACCEPTED BY THE MACOMB COUNTY SURVEY PEER GROUP AS THE OFFICIAL CORNER UNDER MICHIGAN PUBLIC ACT 345 OF 1990 AT A MEETING HELD ON 12-13-94

William E. Soderberg
 WILLIAM E. SODERBERG, P.S., CHAIRMAN

C. Description of monument for corner and accessories established to perpetuate locating the position of the corner:

D-1 I set a 3/4" x 24" iron rod w/2" diameter aluminum cap stamped "Macomb County Monument MI Act 345 #25854" in a new monument box.

- SWM is RLS #30092
- PK & Macomb Co. Remon. Tag Top Curb N Side Eastbound M-59 N 50° E 16.08'
- PK w/SWM Tag NE Face P. Pole S 66° E 179.99'
- PK w/SWM Tag E Face P. Pole S 04° E 60.02'
- PK w/SWM Tag NW Face P. Pole S 72° W 147.14'

The selected location is accepted by me and is generally accepted by professional surveyors as the best available evidence of the position of the original corner.

Signed by Randy J. Kolehouse Date 12/16/94
 Surveyor's Michigan License No. 25854

