

SURVEY & REMONUMENTATION

APR 28 1995

LAND CORNER RECORDATION CERTIFICATE
Filing Requirement of Act 74, Mich. P.A. 1970

C152223

94 DEC 14 AM 10:52

For corners in
MACOMB

COMMISSION

Located In: Clinton
Township Corner Code: #


1. Public Land Survey	T <u>2N</u> R <u>13E</u>		D-5
	T _____ R _____		
	T _____ R _____		
	T _____ R _____		
2. Property Controlling in Section	S _____ T _____ R _____		
	S _____ T _____ R _____		
3. Miscellaneous Property in Sec.	S _____ T _____ R _____		
	S _____ T _____ R _____		

LIBER **6527** PAGE **800**

Register of Deeds Stamp & File Number

4. Lot No. _____, Recorded Plat _____
5. Private Claims _____

I, Randy Kolehouse, in a field survey on July 27, 19 94, do hereby certify that under requirements of P.A. 74, Michigan P.A. of 1970, the corner points mentioned in lines 1 and 2 above were in conformance with regulations and rules therefore as required in the current manual of survey instructions of the United States Department of the Interior, Bureau of Land Management or by a decree of a Court of Law and/or that the corner points mentioned in lines 3, 4 and 5 above were in conformance with the rules of the Michigan Board of Land Surveyors or by a Decree of a Court of Law; established, re-established, monumented, re-monumented, recovered, found as expressed below:

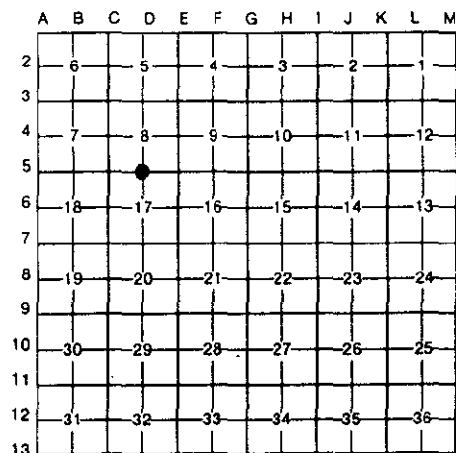

NOTE: Not more than 4 corners, all in the same town and range, may be recorded on this certificate.

A. Description of original monument and accessories and/or subsequent restoration:

D-5	1817	G.L.O.	Notes	Preston	NA	Post
	1974	L.C.R.C.	L. 2553 P. 600	Smith	#16052	1/2" Iron Cap #16052
	1976	Cert Survey	L. 2714 P. 460	Dely	#5234	1/2" Iron Cap #16057
	1988	L.C.R.C.	L. 4404 P. 57	Raines	#14981	3/4" Iron Rod in Mon. Box (S. Edge of 18 Mile Road)

B. Description of corner evidence found and/or method applied in restoring or reestablishing corner:

D-5 Found 3/4" Iron Rod in Mon. Box S. Edge of 18 Mile Road pavement.

L.C.R.C. Liber 4404 P. 57
PK with Shiner NE Side Util. Pole N 49° W 107.13'
PK with Shiner NW Side Util. Pole N 58° E 101.24'
Chiseled "+" on E Side Str. M.H. S 17° E 61.33' (should be West)
PK with Shiner NW Side 5" Poplar S 22° W 65.46'

ACCEPTED BY THE MACOMB COUNTY SURVEY PEER
GROUP AS THE OFFICIAL CORNER UNDER MICHIGAN
PUBLIC ACT 345 OF 1990 AT A MEETING HELD
ON 9-20-94

William E. Soderberg
WILLIAM E. SODERBERG, P.S., CHAIRMAN


This corner was set at midpoint of section line by Robert L. Smith 1974 per L.C.R.C. L. 2553 P. 600. All wit. gone.

Measure E 2726.46 to E-5 (Survey L. 2714 P. 460 = 2726.9) (G.L.O. 2689.5)
Measure W 2726.54 to B-5 (G.L.O. 2689.5)

C. Description of monument for corner and accessories established to perpetuate locating the position of the corner:

D-5 I replaced the found 3/4" Iron Rod with a 3/4" x 24" Iron Rod w/2" diameter aluminum cap stamped "Macomb County Monument MI Act 345 #25854" in an existing Monument Box.

"+" W Side Str. M.H. S 17° E 61.37'
Nail with Shiner NW Face 12" Poplar S 16° W 65.42'
PK NE Face Util. Pole N 55° W 107.13'
PK with Shiner NW Face Util. Pole N 64° E 101.29'

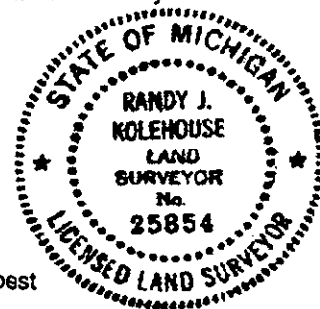

The selected location is accepted by me and is generally accepted by professional surveyors as the best available evidence of the position of the original corner.

Signed by Randy J. Kolehouse
25854

Date 10/14/94

Surveyor's Michigan License No. _____