

LAND CORNER RECORDATION CERTIFICATE
Filing Requirement of Act 74, Mich. P.A. 1970

B997895

For corners in

<u>MACOMB</u> (County)	Located In:	Corner Code #/
	CLINTON TWP.	
1. Public Land Survey	T <u>2N</u> R <u>13E</u>	<u>E-3</u>
	T _____ R _____	_____
	T _____ R _____	_____
	T _____ R _____	_____
2. Property Controlling in Section	S _____ T _____ R _____	_____
	S _____ T _____ R _____	_____
3. Miscellaneous Property in Sec.	S _____ T _____ R _____	_____
	S _____ T _____ R _____	_____
4. Lot No. _____, Recorded Plat _____		
5. Private Claims _____		

LIBER 06161 PG 245

Register of Deeds Stamp & File Number

I, BRUCE ANTCLIFF, in a field survey on NOVEMBER 22, 19 93, do hereby certify that under requirements of P.A. 74, Michigan P.A. of 1970, the corner points mentioned in lines 1 and 2 above were in conformance with regulations and rules therefore as required in the current manual of survey instructions of the United States Department of the Interior, Bureau of Land Management or by a decree of a Court of Law and/or that the corner points mentioned in lines 3, 4 and 5 above were in conformance with the rules of the Michigan Board of Land Surveyors or by a Decree of a Court of Law; established, re-established, monumented, re-monumented, recovered, found as expressed below:

NOTE: Not more than 4 corners, all in the same town and range, may be recorded on this certificate.

A	B	C	D	E	F	G	H	I	J	K	L	M
2	6	5	4	3	2	1						
3												
4	7	8	9	10	11	12						
5												
6	18	17	16	15	14	13						
7												
8	19	20	21	22	23	24						
9												
10	30	29	28	27	26	25						
11												
12	31	32	33	34	35	36						
13												

A. Description of original monument and accessories and/or subsequent restoration:

GLO-Post, NO WITS. REMAIN

EDISON NOTES (1974)-5/8" REROD
 HYD., N63W, 76.79'
 DE POLE, S64W, 67.75'
 MH, S76E, 42.80'
 MBT POLE, S85E, 33.11'
 SW COR HSE #43022, N62E, 130.00'

LCRC (1977) L2900, P636-1/2" REROD
 PK IN MBT POLE, EAST, 32.86'
 PK IN DE POLE, SW, 69.47'
 TOP CENTER HYDRANT, NW, 76.80'
 CENTERLINE GATEWELL, NNW, 80.92'

MCRRC PLANS FOR 19 MILE RD.-1/2" REROD
 AEW TAG IN 48" STUMP, NNW, 128.43'
 TOP CENTER HYDRANT, NW, 76.80'
 AEW TAG IN DE POLE, SW, 67.51'
 AEW TAG IN MBT POLE, EAST, 33.0'

B. Description of corner evidence found and/or method applied in restoring or reestablishing corner:
 FOUND 5/8" REBAR/MON. BOX

FOUND AND VERIFIED TWO OF THE ABOVE WITNESSES.

93 DEC 22 AM 9:05


CARMELLA SABAUGH
 REGISTER OF DEEDS
 MACOMB COUNTY, MI

ACCEPTED BY THE MACOMB COUNTY SURVEY PEER GROUP AS THE OFFICIAL CORNER UNDER MICHIGAN PUBLIC ACT 345 OF 1990 AT A MEETING HELD ON 12-1-93
Frank J. DeDecker
 FRANK J. DeDECKER, P.S., P.E., CHAIRMAN

C. Description of monument for corner and accessories established to perpetuate locating the position of the corner:

SET MACOMB COUNTY REMONUMENTATION MARKER AND CAP #25826 IN EXIST. MON. BOX.
 WITNESSES

TOP CENTER HYDRANT, N60W, 76.46'
 SW COR. HSE #43022, N66E, 129.83'
 FND PK NORTH FACE PP, S54W, 80.25'
 FND N&T #17635 W FACE MBT POLE, S17E, 101.11'

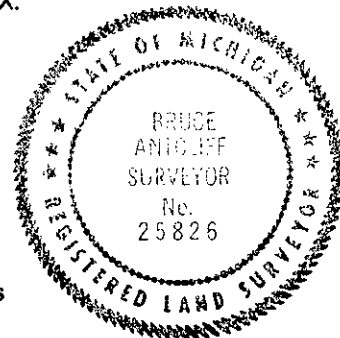

The selected location is accepted by me and is generally accepted by Professional Surveyors as the best available evidence of the position of the original corner.

Signed by Bruce Antcliff

Date 12-9-93

Surveyor's Michigan License No. 25826