

SURVEY & REMONUMENTATION

APR 28 1995

C152225

COMMISSION LAND CORNER RECORDATION CERTIFICATE
Filing Requirement of Act 74, Mich. P.A. 1970

94 DEC 14 AM 10:52

For corners in

MACOMB

(County)

Located In: **Clinton Township**

Corner Code **#E-4**


- 1. Public Land Survey T 2N R 13E E-4
 T _____ R _____
 T _____ R _____
 T _____ R _____
- 2. Property Controlling in Section S _____ T _____ R _____
 S _____ T _____ R _____
- 3. Miscellaneous Property in Sec. S _____ T _____ R _____
 S _____ T _____ R _____

CAL. REC'D MICH. SAUGH DEEDS DEPT. ME

LIBER 6527 PAGE 802

Register of Deeds Stamp & File Number

- 4. Lot No. _____, Recorded Plat _____
- 5. Private Claims _____

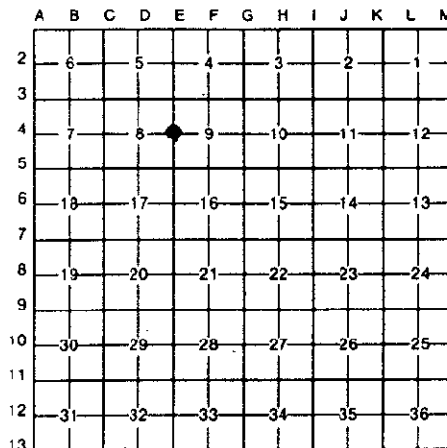

I, **Randy Kolehhouse**, in a field survey on **July 27**, 19 **94**, do hereby certify that under requirements of P.A. 74, Michigan P.A. of 1970, the corner points mentioned in lines 1 and 2 above were in conformance with regulations and rules therefore as required in the current manual of survey instructions of the United States Department of the Interior, Bureau of Land Management or by a decree of a Court of Law and/or that the corner points mentioned in lines 3, 4 and 5 above were in conformance with the rules of the Michigan Board of Land Surveyors or by a Decree of a Court of Law; established, re-established, monumented, re-monumented, recovered, found as expressed below:

NOTE: Not more than 4 corners, all in the same town and range, may be recorded on this certificate.

A. Description of original monument and accessories and/or subsequent restoration:

E-4	1817	G.L.O.	Notes	Preston	NA	Post
	1972	Survey	L. 2285 P. 436	Melching	#14767	Boat Spike
	1972	L.C.R.C.	L. 2285 P. 467	Melching	#14767	Boat Spike
	1972	Survey	L. 2357 P. 391	Soderberg	#17635	Boat Spike
	1974	MCRC	File	Kroll	NA	Boat Spike
	1974	Det. Ed.	Wit. File	NA	NA	Boat Spike
	1978	Survey	L. 3089 P. 939	Soderberg	#17635	Boat Spike
	1979	Survey	L. 3106 P. 715	Soderberg	#17635	Iron
	1987	L.C.R.C.	L. 4340 P. 807	Fenn	#23503	3/4" Iron in Mon. Box

B. Description of corner evidence found and/or method applied in restoring or reestablishing corner:

E-4	Found 5/8" rebar in monument box on center line of Romeo Plank Road. On tree row running west.	
L.C.R.C. L. 2285 P. 467	Cert. Survey L. 3089 P. 939	L.C.R.C. L. 4340 P. 807
Top of Hyd. SW 55.55'	Top of Hyd. SW 55.55'	12" Tree W 43.44'
	6" Oak W 43.44'	Top of Hyd. SW 55.55'
Cert. Survey L. 2285 P. 436	PK in Util. Pole SE 201.82'	PK in Util. Pole E 31.99'
Top Hyd. SW 55.55'	PK in Util. Pole E 31.93'	PK in Util. Pole SE 201.82'

Measure N 2702.81 to E-3 (G.L.O. 2640)
 Measure S 2615.26 to E-5 (Chippewa Meadows Sub. = 2615.34)(G.L.O. 2640)

C. Description of monument for corner and accessories established to perpetuate locating the position of the corner:

- E-4 I replaced the found 5/8" rebar with a 3/4" x 24" Iron Rod w/2" diameter aluminum cap stamped "Macomb County Monument MI Act 345 #25854" in an existing Monument Box.
 PK in S Face Util. Pole S 83° E 31.93'
 PK in W Face Util. Pole S 03° E 201.82'
 Center Line Top Nut Hyd., S 40° W 55.55'
 PK & Macomb Co. Remon Tag in 18" Trf Oak N 82° W 43.44'

The selected location is accepted by me and is generally accepted by professional surveyors as the best available evidence of the position of the original corner.

Signed by Randy J. Kolehhouse Date 10/14/94
 Surveyor's Michigan License No. 25854

ACCEPTED BY THE MACOMB COUNTY SURVEY PEER GROUP AS THE OFFICIAL CORNER UNDER MICHIGAN PUBLIC ACT 345 OF 1990 AT A MEETING HELD ON 9-20-94
 William E. Soderberg, P.S., CHAIRMAN

