

SURVEY & REMONUMENTATION

APR 28 1995

LAND CORNER RECORDATION CERTIFICATE COMMISSION Filing Requirement of Act 74, Mich. P.A. 1970

C152226

94 DEC 14 AM 10:52

For corners in
MACOMB
(County)

Located In: Clinton Township Corner Code E-5


CLERK OF
REGISTERED
DEEDS
MACOMB COUNTY, MI

- | | | | | |
|------------------------------------|--------------------------|-------|-------|-------|
| 1. Public Land Survey | T <u>2N</u> R <u>13E</u> | _____ | _____ | _____ |
| | T _____ R _____ | _____ | _____ | _____ |
| | T _____ R _____ | _____ | _____ | _____ |
| | T _____ R _____ | _____ | _____ | _____ |
| 2. Property Controlling in Section | S _____ T _____ R _____ | _____ | _____ | _____ |
| | S _____ T _____ R _____ | _____ | _____ | _____ |
| 3. Miscellaneous Property in Sec. | S _____ T _____ R _____ | _____ | _____ | _____ |
| | S _____ T _____ R _____ | _____ | _____ | _____ |

LIBER **6527** PAGE **803**

Register of Deeds Stamp & File Number

4. Lot No. _____, Recorded Plat _____
5. Private Claims _____

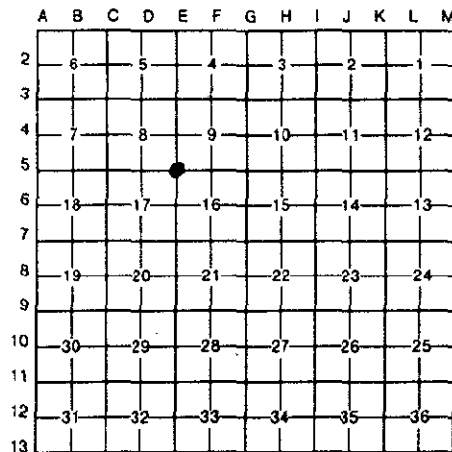

I, Randy Kolehouse, in a field survey on July 26, 19 94, do hereby certify that under requirements of P.A. 74, Michigan P.A. of 1970, the corner points mentioned in lines 1 and 2 above were in conformance with regulations and rules therefore as required in the current manual of survey instructions of the United States Department of the Interior, Bureau of Land Management or by a decree of a Court of Law and/or that the corner points mentioned in lines 3, 4 and 5 above were in conformance with the rules of the Michigan Board of Land Surveyors or by a Decree of a Court of Law; established, re-established, monumented, re-monumented, recovered, found as expressed below:

NOTE: Not more than 4 corners, all in the same town and range, may be recorded on this certificate.

A. Description of original monument and accessories and/or subsequent restoration:

E-5	1817	G.L.O.	Notes	Preston	NA	Post
	NA	MCRC	File #61	NA	NA	R.R. Spike
	1971	Survey	L. 2285 P. 436	Melching	#14767	1" Iron
	1976	Survey	L. 2714 P. 460	Dely	#5234	1" Iron
	1978	L.C.R.C.	L. 2902 P. 557	Soderberg	#17635	3/4" Iron
	1978	Survey	L. 3089 P. 939	Soderberg	#17635	3/4" Iron
	1979	Survey	L. 3218 P. 061	Soderberg	#17635	3/4" Iron
	1980	Survey	L. 3213 P. 415	Soderberg	#17635	3/4" Iron
	1987	L.C.R.C.	L. 4340 P. 807	Fenn	#23505	1/2" Iron in Mon. Box

B. Description of corner evidence found and/or method applied in restoring or reestablishing corner:

E-5 Found 1/2" Iron in Monument Box 5' ± E of the center line of Romeo Plank Road. Checks all witnesses as shown in L.C.R.C. L. 4340 P. 807. All other witnesses have been destroyed.

- Measure N 2615.26 to E-4 (Chippewa Meadows Sub. - 2615.34) (G.L.O. 2640)
- Measure S 2643.90 to E-6 (G.L.O. 2640)
- Measure W 2726.46 to D-5 (G.L.O. 2689.5)


ACCEPTED BY THE MACOMB COUNTY SURVEY PEER GROUP AS THE OFFICIAL CORNER UNDER MICHIGAN PUBLIC ACT 345 OF 1990 AT A MEETING HELD ON 9-20-94
William E. Soderberg
WILLIAM E. SODERBERG, P.S., CHAIRMAN

C. Description of monument for corner and accessories established to perpetuate locating the position of the corner:

E-5 I replaced the found 1/2" Iron with a 3/4" x 24" Iron Rod w/2" diameter aluminum cap stamped "Macomb County Monument MI Act 345 #25854" in an existing Monument Box.

- PK & Tag #17635 NW Face Util. Pole N 14° E 180.44'
- PK & Tag #17635 NW Face Util. Pole N 54° E 32.22'
- PK & Tag #17635 W Face Util. Pole S 03° E 163.60'
- "+" N Rim M.H. S 21° W 162.73'
- Plat Monument N 85° W 59.6'

The selected location is accepted by me and is generally accepted by professional surveyors as the best available evidence of the position of the original corner.

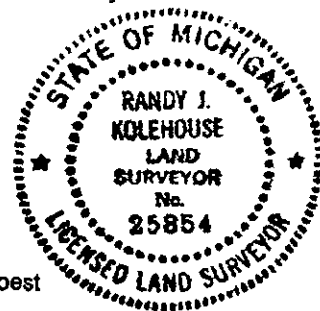

Signed by Randy J. Kolehouse
Surveyor's Michigan License No. 25854

Date 10/14/94