

# SURVEY & REMONUMENTATION

APR 28 1995

## LAND CORNER RECORDATION CERTIFICATE COMMISSION Filing Requirement of Act 74, Mich. P.A. 1970

C152227

94 DEC 14 AM 10:52

For corners in  
MACOMB  
(County)

Located In: Clinton Township Corner Code ##

CAMPBELL  
REGISTERED  
LAND SURVEYOR  
MACOMB COUNTY, MI

1. Public Land Survey	T <u>2N</u>	R <u>13E</u>			E-6
	T _____	R _____			
	T _____	R _____			
	T _____	R _____			
2. Property Controlling in Section	S _____	T _____	R _____		
	S _____	T _____	R _____		
3. Miscellaneous Property in Sec.	S _____	T _____	R _____		
	S _____	T _____	R _____		

LIBER 6527 PAGE 804

Register of Deeds Stamp & File Number

4. Lot No. \_\_\_\_\_, Recorded Plat \_\_\_\_\_  
5. Private Claims \_\_\_\_\_

	A	B	C	D	E	F	G	H	I	J	K	L	M
2	6		5		4		3		2				
3													
4	7		8		9		10		11		12		
5													
6	18		17	●	16		15		14		13		
7													
8	19		20		21		22		23		24		
9													
10	30		29		28		27		26		25		
11													
12	31		32		33		34		35		36		
13													

I, Randy Kolehouse, in a field survey on June 26, 19 94, do hereby certify that under requirements of P.A. 74, Michigan P.A. of 1970, the corner points mentioned in lines 1 and 2 above were in conformance with regulations and rules therefore as required in the current manual of survey instructions of the United States Department of the Interior, Bureau of Land Management or by a decree of a Court of Law and/or that the corner points mentioned in lines 3, 4 and 5 above were in conformance with the rules of the Michigan Board of Land Surveyors or by a Decree of a Court of Law; established, re-established, monumented, re-monumented, recovered, found as expressed below:

**NOTE: Not more than 4 corners, all in the same town and range, may be recorded on this certificate.**

**A. Description of original monument and accessories and/or subsequent restoration:**

E-6	1817	G.L.O.	Notes	Preston	NA	Post
	1974	L.C.R.C.	L. 2553 P. 508	Smith	#16052	1/2" Iron Pipe
	1976	Survey	L. 2714 P. 462	Dely	#5234	1/2" Iron Pipe
	1978	L.C.R.C.	L. 2902 P. 557	Soderberg	#17635	3/4" Pipe
	1979	Survey	L. 3168 P. 975	Smith	#16052	3/4" Pipe
	1981	Survey	L. 3350 P. 747	Smith	#16052	3/4" Pipe
	1990	L.C.R.C.	L. 4611 P. 896	Soderberg	#17635	5/8" Rerod in M.B.
		MCRC				2" Wood Stake

**B. Description of corner evidence found and/or method applied in restoring or reestablishing corner:**

E-6 Found 5/8" rebar in monument box 5' ± East of center line of Romeo Plank Road on tree line East.

L.C.R.C. L. 2553 P. 508  
PK and Cap in P. Pole E 31.66'

L.C.R.C. L. 4611 P. 896  
PK and Tag 17635 SSE 209.7'  
East Edge Conc. E 5.65'  
PK and Tag #17635 Util. Pole E 32.45'  
60d Nail in Util. Pole W 33.49'

L.C.R.C. L. 2902 P. 557  
Cap 19837 E Face D.E. Pole WNW 32.83'  
Cap 19837 W Face D.E. Pole E 31.66'

Measure N 2643.90 to E-5 (Survey L. 2714 P. 460 2644.0) (G.L.O. 2640)  
Measure S 2978.65 to E-7 (G.L.O. No Dist. Given)


**C. Description of monument for corner and accessories established to perpetuate locating the position of the corner:**

E-6 I replaced the found 5/8" rebar with a 3/4" x 24" Iron Rod w/2" diameter aluminum cap stamped "Macomb County Monument MI Act 345 #25854" in an existing Monument Box.

PK and Tag #17635 N Face Util. Pole S 86° E 32.37'  
PK and Tag #17635 NE Face Util. Pole S 03° E 209.70'  
PK and Tag # 19837 E Face Util. Pole S 80° W 32.83'  
Center Line Top Nut on Hyd. S 16° W 225.42'  
E Edge Conc. Road E 5.67'

The selected location is accepted by me and is generally accepted by professional surveyors as the best available evidence of the position of the original corner.

ACCEPTED BY THE MACOMB COUNTY SURVEY PEER GROUP AS THE OFFICIAL CORNER UNDER MICHIGAN PUBLIC ACT 345 OF 1990 AT A MEETING HELD ON 9-20-94  
*William E. Soderberg*  
WILLIAM E. SODERBERG, P.S., CHAIRMAN

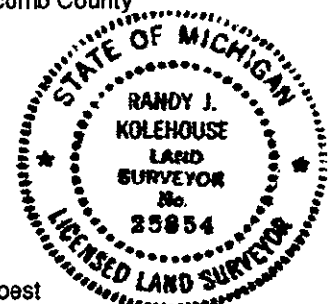

Signed by *Randy J. Kolehouse* Date 10/14/94  
Surveyor's Michigan License No. 25854