

SURVEY & REMONUMENTATION

APR 28 1995

C152228

LAND CORNER RECORDATION CERTIFICATE

Filing Requirement of Act 74, Mich. P.A. 1970

For corners in
MACOMB
(County)

COMMISSION

Located In: Clinton Township Corner Code ##


1. Public Land Survey	T	<u>2N</u>	R	<u>13E</u>	<u>E-7</u>
	T		R		
	T		R		
	T		R		
2. Property Controlling in Section	S		T	R	
	S		T	R	
3. Miscellaneous Property in Sec.	S		T	R	
	S		T	R	

94 DEC 14 AM 10:52
HIGH DEEDS DIV. MI

LIBER **6527** PAGE **805**
Register of Deeds Stamp & File Number

4. Lot No. _____, Recorded Plat _____
5. Private Claims _____

I, Randy Kolehouse, in a field survey on June 26, 19 94, do hereby certify that under requirements of P.A. 74, Michigan P.A. of 1970, the corner points mentioned in lines 1 and 2 above were in conformance with regulations and rules therefore as required in the current manual of survey instructions of the United States Department of the Interior, Bureau of Land Management or by a decree of a Court of Law and/or that the corner points mentioned in lines 3, 4 and 5 above were in conformance with the rules of the Michigan Board of Land Surveyors or by a Decree of a Court of Law; established, re-established, monumented, re-monumented, recovered, found as expressed below:

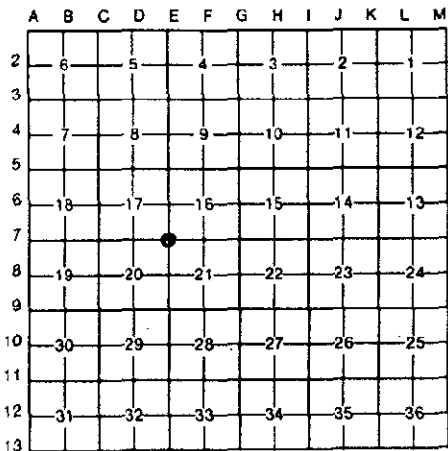

NOTE: Not more than 4 corners, all in the same town and range, may be recorded on this certificate.

A. Description of original monument and accessories and/or subsequent restoration:

E-7	1817	G.L.O.	Notes	Preston	NA	Post
	1976	Survey	L. 2714 P. 460	Dely	#5234	NA
			Moravian Hills Sub. No. 2 L. 66 P. 16			

B. Description of corner evidence found and/or method applied in restoring or reestablishing corner:

E-7 Found 1/2" rebar per Moravian Hills Sub. No. 2 L. 66 P. 16. Checks ties to lot corners - Lot 219. Survey L. 2714 P. 460 does not show type of corner or witness. I believe that the Section lines were illustrated and not run out as the Section corner used in Moravian Hills Sub. No. 2 computes to be approximately 313' South of point shown in Survey L. 2714 P. 460. Section corner shown in Moravian Sub. No. 2 computes to be 2310.0 feet North of the SW corner fraction Section 21 which checks G.L.O.

Measure W 2846.68 to D-7 (G.L.O. No. Dist. Given)
Measure N 2978.65 to E-6 (G.L.O. No. Dist. Given)

ACCEPTED BY THE MACOMB COUNTY SURVEY PEER GROUP AS THE OFFICIAL CORNER UNDER MICHIGAN PUBLIC ACT 345 OF 1990 AT A MEETING HELD ON 9-20-94
William E. Soderberg
WILLIAM E. SODERBERG, P.S., CHAIRMAN

C. Description of monument for corner and accessories established to perpetuate locating the position of the corner:

E-7 I replaced the found 1/2" rebar with a 3/4" x 24" Iron Rod w/2" diameter aluminum cap stamped "Macomb County Monument MI Act 345 #25854."

- SE Corner Hse. 3875 N 64° W 91.06'
- Rebar NE Cor. Lot 219 M.H. Sub. No. 2 North 24.05'
- PK & Macomb Co. Remon. Tag in W Face 15° Elm N 22° E 16.98'
- PK & Macomb Co. Remon. Tag in N Face 15° Elm S 70° E 20.41'
- PK & Macomb Co. Remon. Tag in E Face 18° Poplar S 40° W 12.60'



The selected location is accepted by me and is generally accepted by professional surveyors as the best available evidence of the position of the original corner.

Signed by *Randy J. Kolehouse* Date 10/14/94
Surveyor's Michigan License No. 25854