

SURVEY & REMONUMENTATION

APR 28 1995

LAND CORNER RECORDATION CERTIFICATE Filing Requirement of Act 74, Mich. P.A. 1970

C152229

For corners in **COMMISSION**
MACOMB
(County)

Located In: **Clinton Township** Corner Code #

- | | | | | |
|------------------------------------|-------------|--------------|---------|--|
| 1. Public Land Survey | T <u>2N</u> | R <u>13E</u> | F-1 | |
| | T _____ | R _____ | | |
| | T _____ | R _____ | | |
| | T _____ | R _____ | | |
| 2. Property Controlling in Section | S _____ | T _____ | R _____ | |
| | S _____ | T _____ | R _____ | |
| 3. Miscellaneous Property in Sec. | S _____ | T _____ | R _____ | |
| | S _____ | T _____ | R _____ | |


94 DEC 14 AM 10:52

RECORDED
MICHIGAN
COUNTY, MI

LIBER 6527 PAGE 806

Register of Deeds Stamp & File Number

4. Lot No. _____, Recorded Plat _____
5. Private Claims _____

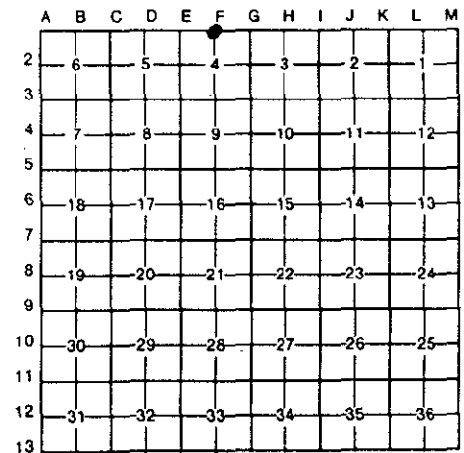

I, **Randy Kolehouse**, in a field survey on **September 28**, 19 **94**, do hereby certify that under requirements of P.A. 74, Michigan P.A. of 1970, the corner points mentioned in lines 1 and 2 above were in conformance with regulations and rules therefore as required in the current manual of survey instructions of the United States Department of the Interior, Bureau of Land Management or by a decree of a Court of Law and/or that the corner points mentioned in lines 3, 4 and 5 above were in conformance with the rules of the Michigan Board of Land Surveyors or by a Decree of a Court of Law; established, re-established, monumented, re-monumented, recovered, found as expressed below:

NOTE: Not more than 4 corners, all in the same town and range, may be recorded on this certificate.

A. Description of original monument and accessories and/or subsequent restoration:

F-1	1817	G.L.O.	Notes	Wampler	NA	Post
	1974	L.C.R.C.	L. 2480 P. 474	Smith	#16052	Found RR Spike

B. Description of corner evidence found and/or method applied in restoring or reestablishing corner:

F-1 Railroad spike as shown in L.C.R.C. L. 2480 P. 474 appears to be set on the north line of Township on the northerly extension of the west line of Private Claim 610, said point being 2958.34 East of the NW corner of Section 4. Per G.L.O. notes, a post was set for the North 1/4 corner of Section 4 at the mid point of the Section. All subdivisions in the North 1/2 of Section 4 use the NE, NW corners of Section and/or the point shown in L.C.R.C. 2480 P. 474. Decided to set point at mid point for F-1 on line between F-13/G-13 T3N R13E. This point is 594.25 E of F-13 T3N R13E G.L.O. = 574.2.

Measure W 2669.6' to E-1
Measure E 2669.6 to G-1

ACCEPTED BY THE MACOMB COUNTY SURVEY PEER GROUP AS THE OFFICIAL CORNER UNDER MICHIGAN PUBLIC ACT 345 OF 1990 AT A MEETING HELD ON 10-4-94
William E. Soderberg
WILLIAM E. SODERBERG, P.S., CHAIRMAN

C. Description of monument for corner and accessories established to perpetuate locating the position of the corner:

F-1 I placed a 3/4" x 24" Iron Rod w/2" diameter aluminum cap stamped "Macomb County Monument MI Act 345 #25854," also set Monument Box.

- | | |
|--|----------------------------------|
| PK & Macomb Co. Remon. Tag in SW Face P. Pole S 70° E 289.68' | C/L Top Nut Hyd. S 43° W 64.07' |
| PK & Macomb Co. Remon. Tag in NE Face 8" Poplar S 34° E 101.49' | C/L Top Nut Hyd. S 66° E 198.12' |
| Set "+" NE Rim G.V&W at SW corner Hall & Centere Ct. S 61° W 115.72' | C/L Sign Post N 17° W 28.95' |
| C/L Asphalt between Hall Road (M-59) South 3' | |

Property controlling cor. (int. west line P.C. 610 & north line Section) East 288.74' (Calculated)

The selected location is accepted by me and is generally accepted by professional surveyors as the best available evidence of the position of the original corner.

Signed by *Randy J. Kolehouse*
Surveyor's Michigan License No. 25854

Date 10/14/94

